


DATE 10-20-90

TOWN OF LEXINGTON — BOARD OF PUBLIC WORKS
SEWER DIVISION

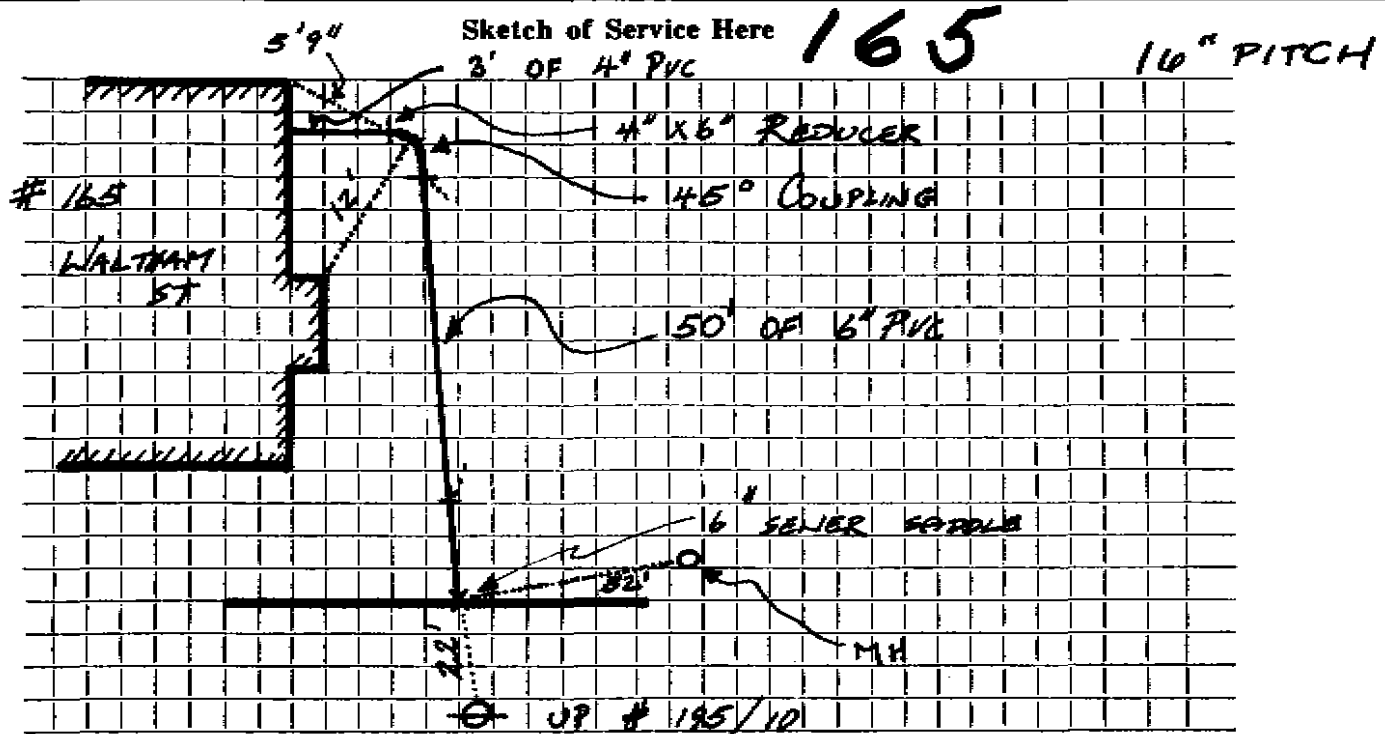

Connection made in WALTHAM Street. Work completed

Remarks: ..INSPECTED..... 10-20-90..... BY I.N..... CONTRACTOR J. McLAUGHLIN.....