


DATE _____

TOWN OF LEXINGTON — BOARD OF PUBLIC WORKS

SEWER DIVISION

Sketch of Service Here

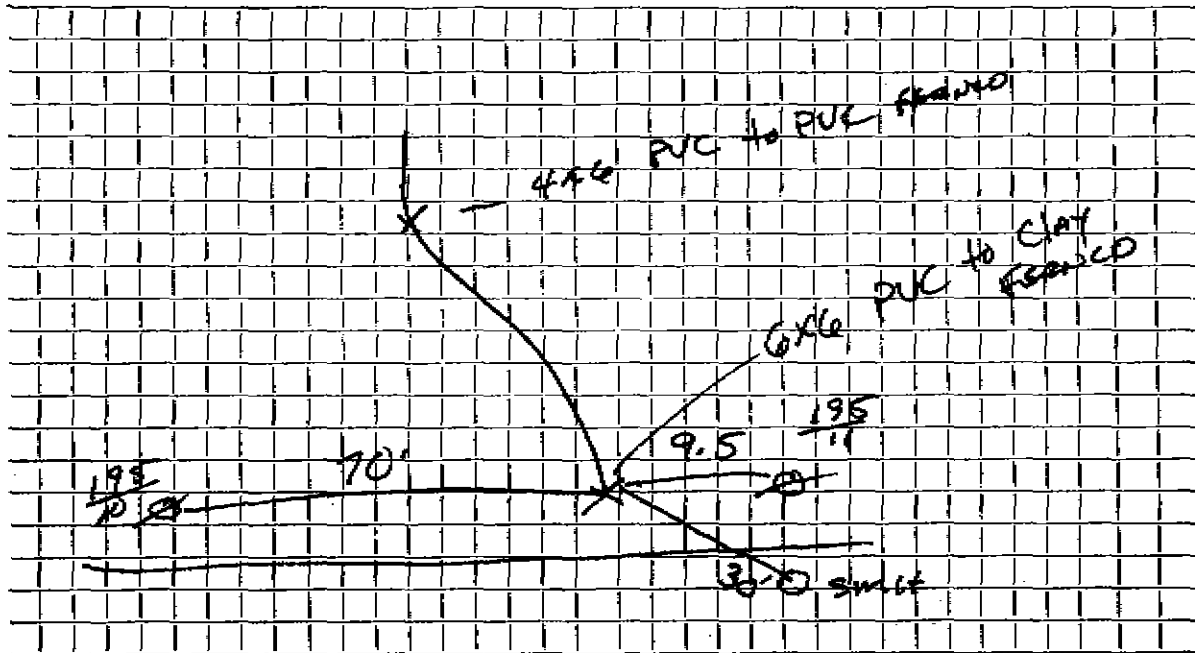

Connection made in _____ Street. Work completed _____

Remarks: _____

Old House torn down

Carver Brothers

Service No. 146

Address 172 Waltham Street

Lexington, Mass. 172 Waltham St. Location 172 Waltham Street

Kind of Pipe

Size 6"

Size of Main 8"

~~Duplex~~ ~~Removal~~ X New Service

Com. 8-6-51

Location

Date	Material	Amount	Total	Date	Amount
29-51	Labor	16 72		May 16 51	200 00
31-51	Labor	16 73	33 45	8-9-51	(47 84)
	10% Overhead		3 35		152 16
	58' - 6" Sewer Pipe @ .36		20 88		
	Joint Compound		3 48		
	Littlefield Shovel 9 hrs. @ 7.00		63 00		
	Trucking 4 hrs. @ .75		3 00		
	Patching 25 x 3		25 00		
			152 16		
	Labor				

TOWN OF LEXINGTON—DEPT. OF PUBLIC WORKS
SEWER DIVISION

DATE

NO.


The undersigned applies for the construction of a particular sewer connecting No.
Street and hereby agrees to comply with the Rules and Regulations governing the construction and use of Particular
Sewers, as now or at any future time established by the Board of Selectmen.

Am't of estimate \$.

Am't Paid \$.

..... Owner

Sketch of Service Here

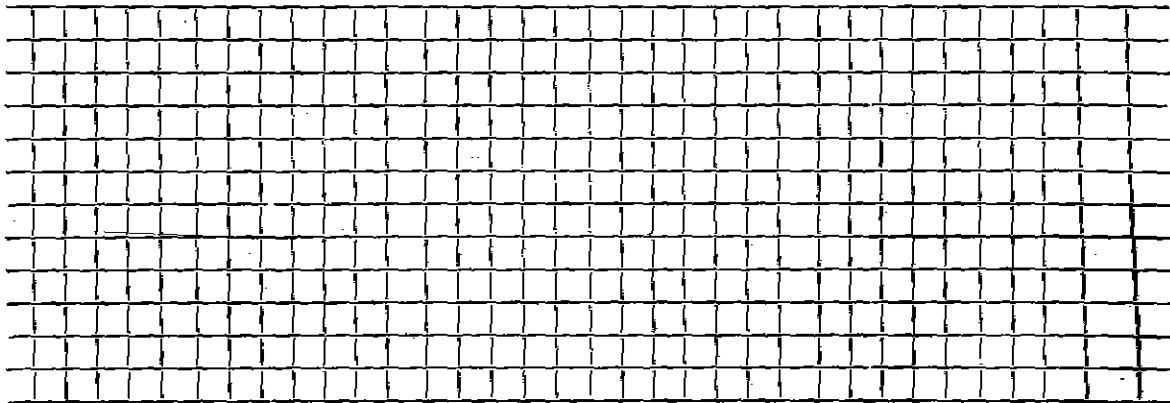

Connection made in Street.

Work completed 19..

Remarks: