

Name Sinclair LockeService No. 4 1951Address 173 Waltham Street173 Waltham StreetLocation 173 Waltham Street

Kind of Pipe

Size 6"Size of Main 8"~~Repair~~ ~~Work~~ New Service

Location

Date	Material	Amount	Total	Date	Amount
Apr. 30, '45	Labor	46 26		April 45	100 00
May 1, '45	"	58 46			(No Additional Chg)
May 2, '45	"	15 27		10-28-82	Renewal
	Previously laid	48 00	167 99		2' 6" Transite Nipple
	10% Overhead		16 80		1 6"-11 1/4" Elbow
	37' - 6" Sewer Pipe		8 14		1 6" Clay To AC Fernco
	10' - 4" Soil Pipe @.50		5 00		
	Joint Compound		2 40		
	Trucking 4 hrs. @.75		3 00		
	Patching 11 x 3		7 32		
			210 65		
	Labor			12/15/70	Solids
				12-5-77	Solids
				9-9-82	Parts 65' to 70' out from house

TOWN OF LEXINGTON—DEPT. OF PUBLIC WORKS

SEWER DIVISION

DATE .....

NO. ....


The undersigned applies for the construction of a particular sewer connecting No. .... Street and hereby agrees to comply with the Rules and Regulations governing the construction and use of Particular Sewers, as now or at any future time established by the Board of Selectmen.

Am't of estimate \$.....

Am't Paid \$.....

..... Owner

Sketch of Service Here **173**

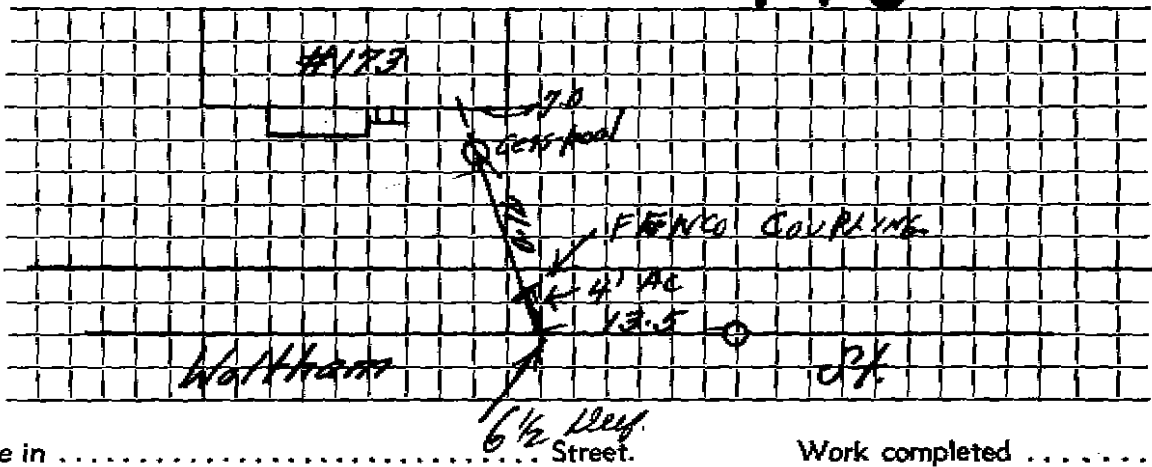

Connection made in ..... Street. Work completed ..... 19..

Remarks: