


DATE _____

TOWN OF LEXINGTON — BOARD OF PUBLIC WORKS

SEWER DIVISION

Sketch of Service Here

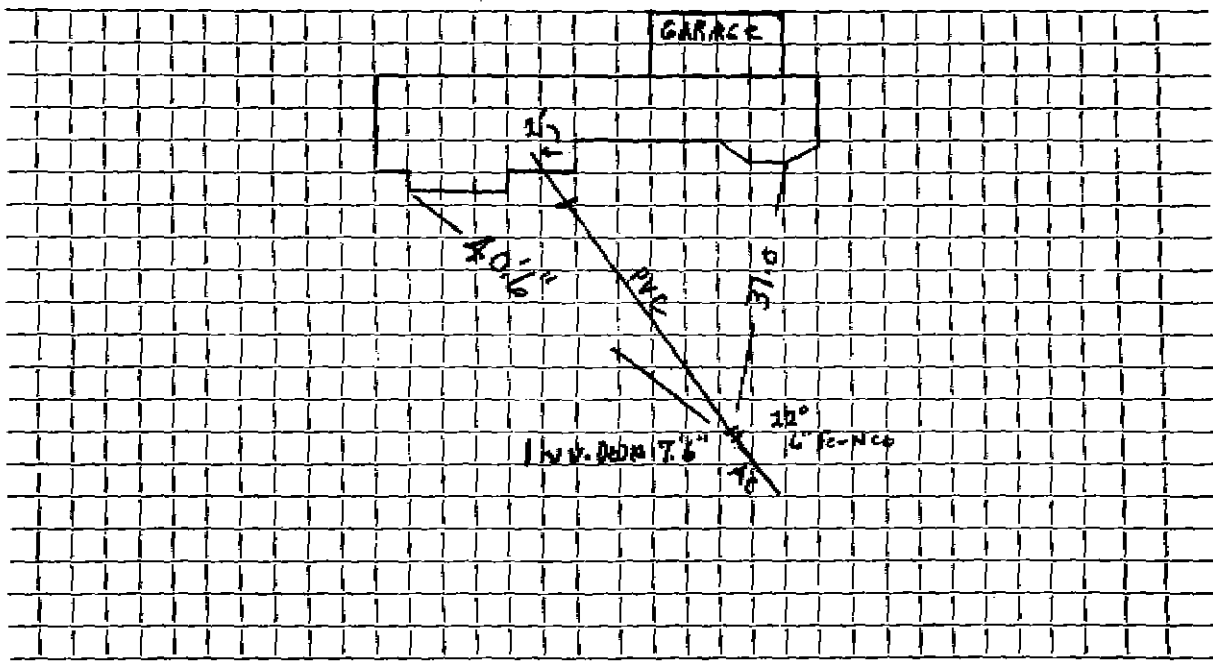

Connection made in _____ Street. Work completed 3/30/04

Remarks: ORIGINAL SERVICE 5/29/51