

Address **178 Waltham St.**
178 Waltham Street Location **178 Waltham St.,**

Kind of Pipe

Size **6"**

Size of Main **8"**

Repair—Renewal—New Service

Location

Date 1941	Material	Amount	Total	Date	Amount
April 29	24½ hrs. @ 50¢	12 25		Apr 16 1941 Deposited	65 00
from 6/30/41	9½ " @ 55¢	5 23		May 10 1941 Paid	10 95
	54½ " @ 60¢	32 30		July 29, 1941 Paid	58 50
	34 " @ 65¢	22 10			134 45
	9 " @ 75¢	6 75	78 63		Bal Due 58.50
	10% Overhead		7 36		
	42' 6" Sewer Pipe @ 16¢		6 72		
	1 6" 1/8 Bend		60		
	Jointing compound		2 52		
	Trucking 4 hrs. @ 75¢		3 00		
	Trench repairs		24 99		
	Compressor- 4½ hrs. @ 2.25		10 13		
			134 45		
	Labor				
Credit refund of 10.95 from Order # 20					

Sawney Franch. Inc., Lexington

TOWN OF LEXINGTON - BOARD OF PUBLIC WORKS

SEWER DIVISION

DATE

Feb 25

Waltham

NO

178 Waltham St

The undersigned applies for the construction of a particular sewer connecting No. 178 Waltham St Street and hereby agrees to comply with the Rules and Regulations governing the construction and use of Particular Sewers, as now or at any future time established by the Board of Selectmen.


Am't. of Estimate \$ 90.⁰⁰ Water + Sewer -
town digs

Galbraith

Am't. Paid \$ _____

Thomas Galbraith Owner

Sketch of Service Here

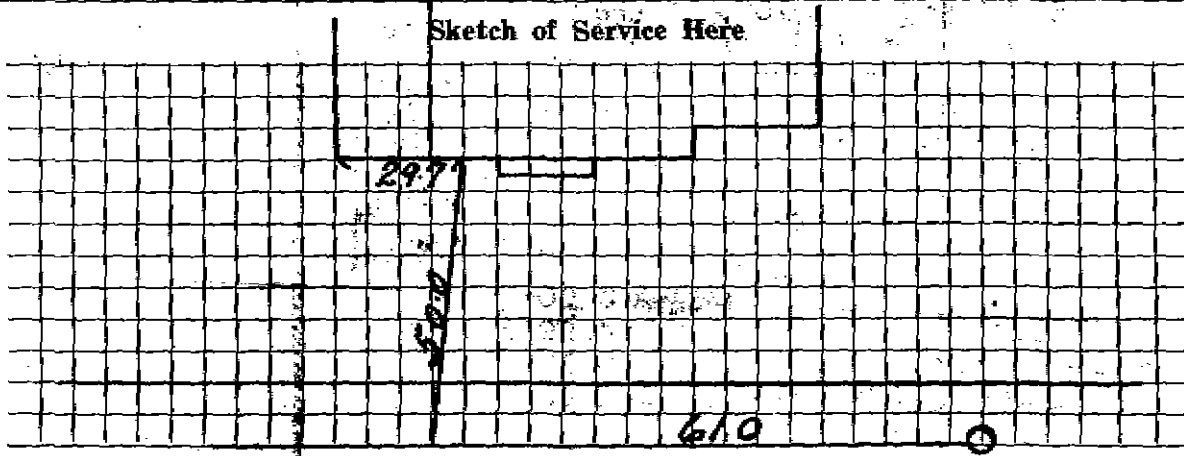

Connection made in _____

Street.

Work completed _____

19

Remarks: