

182 Waltham Street

Size of Main 8"

Size 6"

Location

New Service

Date	Material	Amount	Total	Date	Amount
8/23/30	48 1/2" Sewer Pipe @ .30	14.40		July 18 1931 - Cash	104.44
	10 1/4" Iron " @ .50	5.00			
	Sulphur & Jute	1.92			
	Trucking	75	\$22.07		
8/30	hrs. Labor @ .55	55.65			
30	" " @ .60	18.00	71.65		
	15% Overhead		10.74		
			104.44		
	Time in for water & sewer services				
	Labor				

TOWN OF LEXINGTON—BOARD OF PUBLIC WORKS

SEWER DIVISION

DATE July 15, 1929

NO. _____


The undersigned applies for the construction of a particular sewer connecting No. 50 Waltham St. Street and hereby agrees to comply with the Rules and Regulations governing the construction and use of Particular Sewers, as now or at any future time established by the Board of Selectmen.

Am't. of Estimate \$ _____

Am't. Paid \$ _____

Elizabeth F. McIntosh Owner

Sketch of Service Here

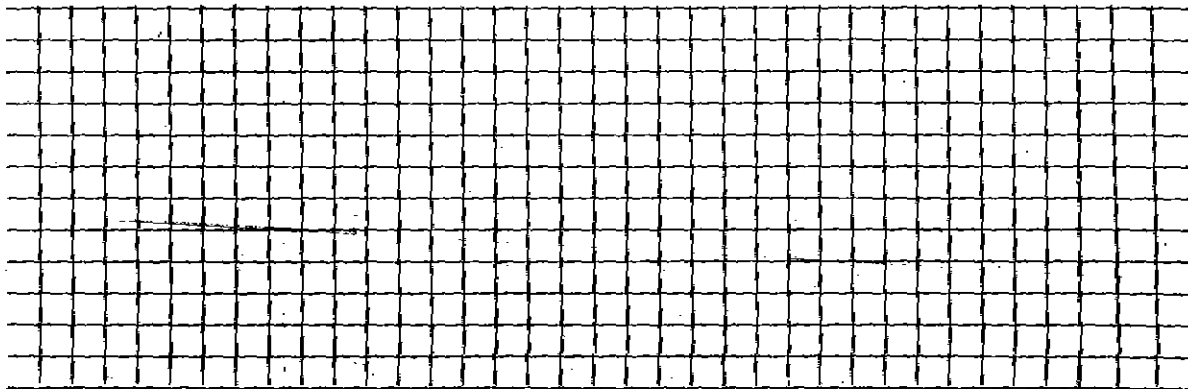

Connection made in _____ Street.

Work completed _____ 19

Remarks: