

Name Mildred P. Beatty

861-8568

Service No. 67

Address 183 Waltham Street

183 Waltham Street

Location

Kind of Pipe

Size 6"

Size of Main 8"

Repair—Renewal—New Service W.O.#8809 Eagle #1636


Location NOV 23 1970

Date	Material	Amount	Total	Date	Amount
1/24/70	Labor	75.90		7-17-70	490.00
1/30/70	"	127.04		7-22-70	48.52
1/12/70	"	62.36			5.38 53
1/30/70	"	80.64	345.94		
	10% O.H.	34.59	380.53		
	10' 6" Transite pipe @.90		9.00		
	2 Ton Cold Patch @6.00		12.00		
	5 Ton Hot Top @6.00		30.00		
	7 hrs. Trucking @3.00		21.00		
	7 hrs. Town Shovel @6.50		45.50		
	5 hrs. Compressor @5.00		25.00		
	1 1/2 hrs. Loader @5.00		7.50	3-27-76	Root 33' 24'
	2 hrs. Roller @3.00		6.00		
	1 hr. Trailer		2.00		
11/70	39' 4" Cast Iron Pipe		538.53		

DATE \_\_\_\_\_

TOWN OF LEXINGTON — BOARD OF PUBLIC WORKS

SEWER DIVISION

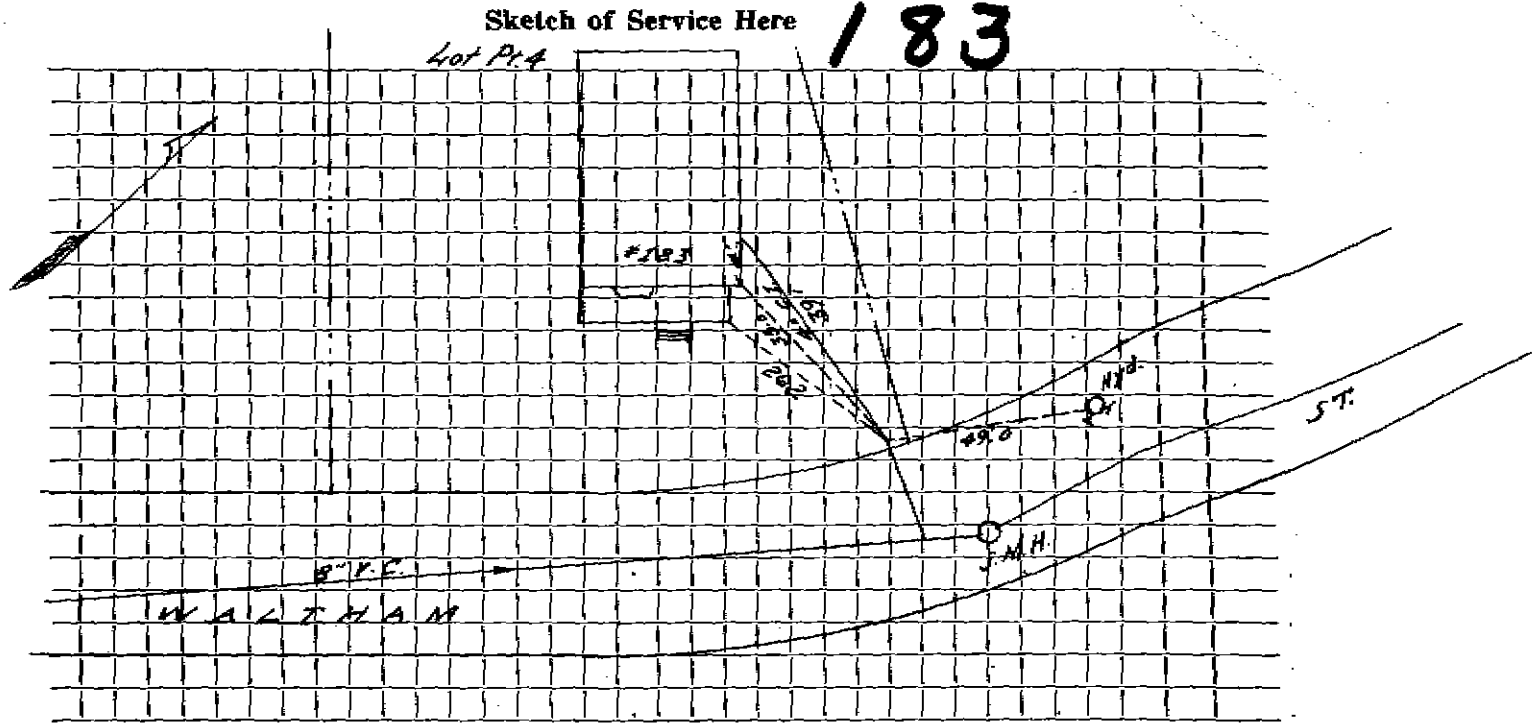

Connection made in ..... Street. Work completed .....

Remarks: .....

.....  
.....