


DATE 12-15-82

TOWN OF LEXINGTON — BOARD OF PUBLIC WORKS
SEWER DIVISION

Sketch of Service Here

191

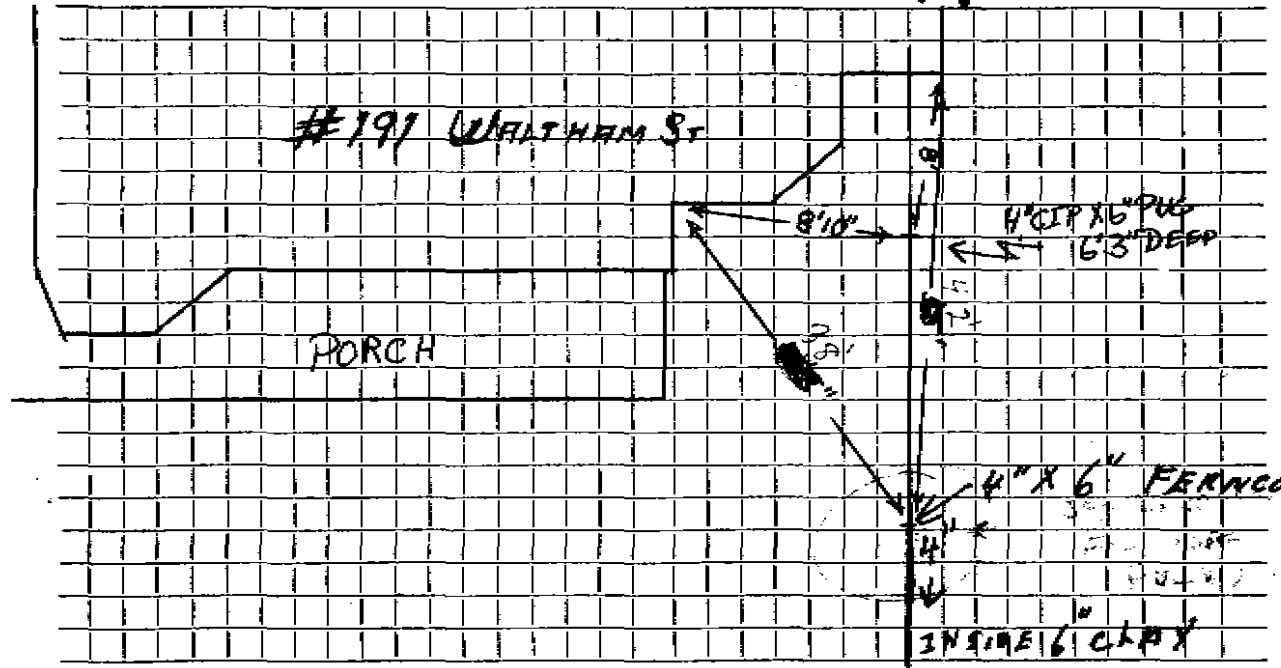

Connection made in WALTHAM ST Street. Work completed

Remarks: 4" PVC STOPS 5' SHORT OF MAIN