

Charles D. Visser, Engineer
 50 Federal Street, Boston, Mass.

Service No. 75 501

194 Waltham St. Location 194 Waltham Street

Kind of Pipe Size 6" Size of Main 8"

Character of Work - New Service Location

Date	Material	Amount	Total	Date	Amount
1937					
Mar. 4.	29 hrs. @ .50	14 50		Feb. 25 1937 paid	120 00
Cons-9-37	42 1/2 " @ .55	23 38		3-10-37 Refunded	21 38
	20 1/2 " @ .60	12 30	50 18		98 62
	Overhead		5 01		
			55 19		
	32' 6" Sewer Pipe @ 20¢		6 40		
	10' 4" Soil Pipe		5 00		
	1 6" Bend		90		
	1 6 x 4 Reducer		90		
	16 joints G.K. @ 10¢		1 60		
	1 1/2 hrs. compressor @ 3.00		4 50		
	5 1/2 " trucking @ 75¢		4 15		
	10' curb to main @ 2.00		20 00		
			98 62		
	Labor				
	No trench repairs - service in street before reconstruction of st.				

Equacy Prob. Inc., Lexington

TOWN OF LEXINGTON—BOARD OF PUBLIC WORKS
SEWER DIVISION

DATE _____


NO. _____

The undersigned applies for the construction of a particular sewer connecting No. _____ Street and hereby agrees to comply with the Rules and Regulations governing the construction and use of Particular Sewers, as now or at any future time established by the Board of Selectmen.

Am't. of Estimate \$ _____

Am't. Paid \$ _____

Owner

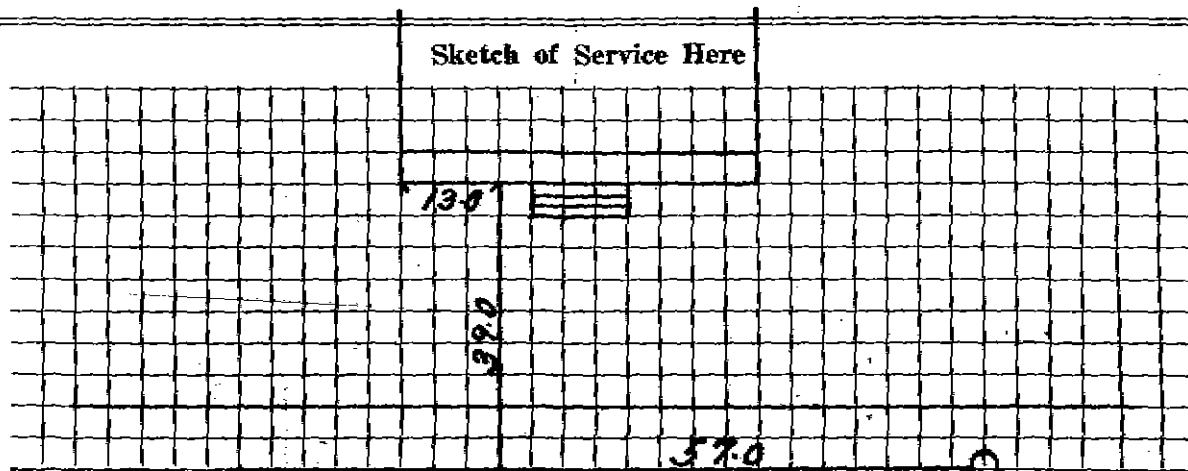

Connection made in _____ Street.

Work completed _____ 19

Remarks: