

Blank, Walter G.

Service No. 1569

Address 11 Highway Ave., Lexington

1954-197 Wolfram At Location 185 Waltham St., Lexington

Kind of Pipe

Size 6"

Size of Main 8"

Repaired/Replaced-New Service

Location

Date	Material	Amount	Total	Date	Amount
1936 7/28	37 1/2 hrs. labor @ 55¢	20 63		July 18 1936	71 00
Levy held to Route 1 95.00	29 " @ 60¢	17 40	38 03	Deposit	
	10% Ovhd. on labor		3 80		
	30' 6" Sewer Pipe @ 16¢	4 80			
	2 1/8 6" Bands @ 65¢	1 30			
	Joint. Comp.	30			
	Trucking	1 00			
	20' in Street @ \$1.50	30 00	37 40		
	No Trench Repairs		79 23		
	Say:		75 00		
	Labor				

TOWN OF LEXINGTON—BOARD OF PUBLIC WORKS

SEWER DIVISION

DATE July 17, 1936

NO. 195 Waldham St.


The undersigned applies for the construction of a particular sewer connecting No. 195 Waldham St. Street and hereby agrees to comply with the Rules and Regulations governing the construction and use of Particular Sewers, as now or at any future time established by the Board of Selectmen.

Am't. of Estimate \$ 7500

Am't. Paid \$ _____

Walter G. Black Owner

Sketch of Service Here

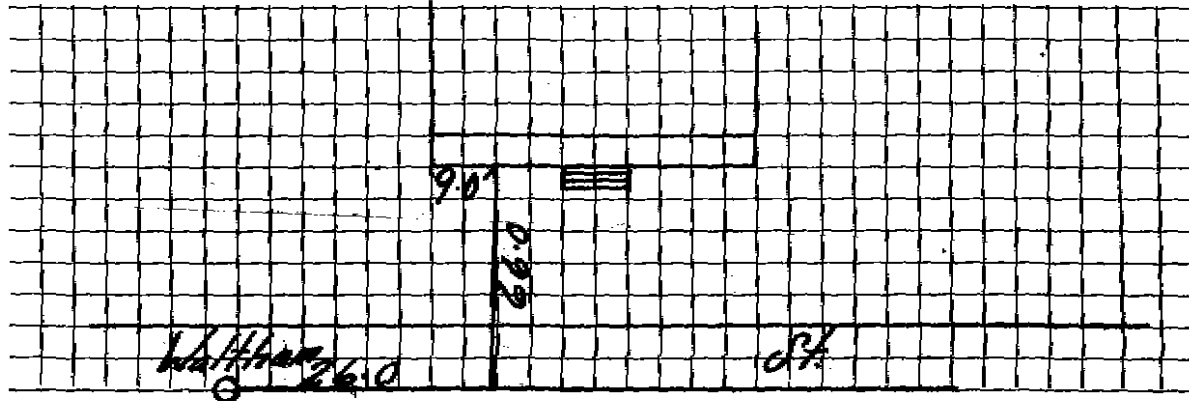

Connection made in _____ Street. Work completed _____ 19 _____

Remarks: