


TOWN OF LEXINGTON — BOARD OF PUBLIC WORKS
WATER DIVISION

Sketch of Service Here

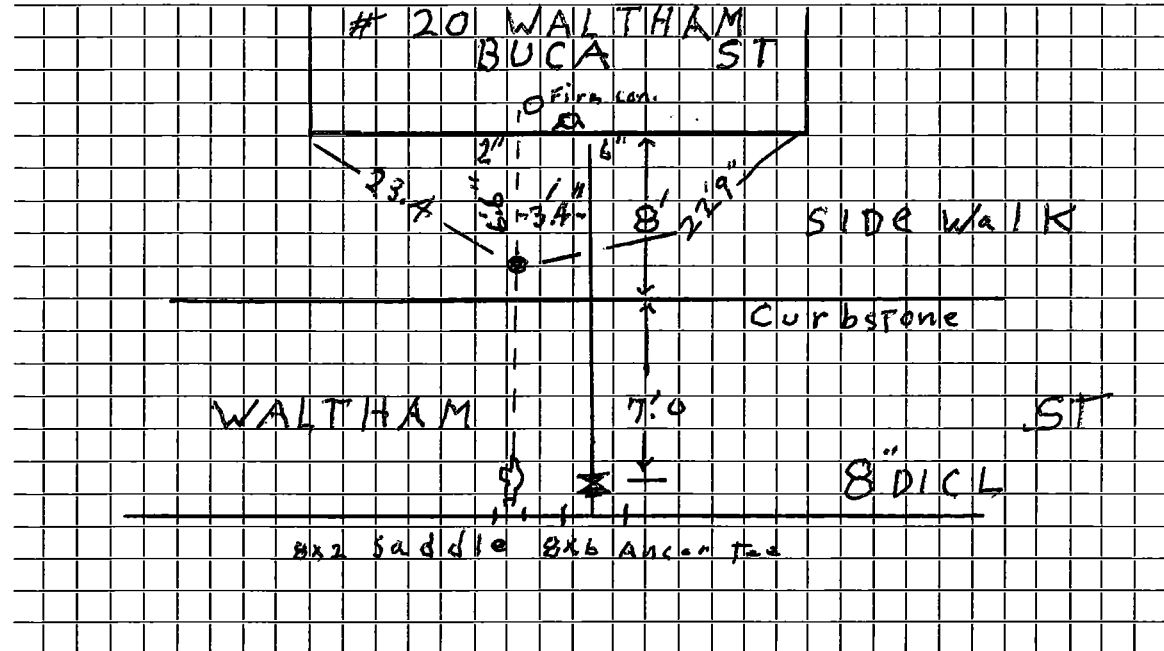

Connection made in Street. Work completed 8/2011 Cranes

Remarks: 3'4" / 2" to 6" w / 6" w To Sewer 1/6"

.....

.....