




DATE \_\_\_\_\_

TOWN OF LEXINGTON — BOARD OF PUBLIC WORKS

SEWER DIVISION

Sketch of Service Here

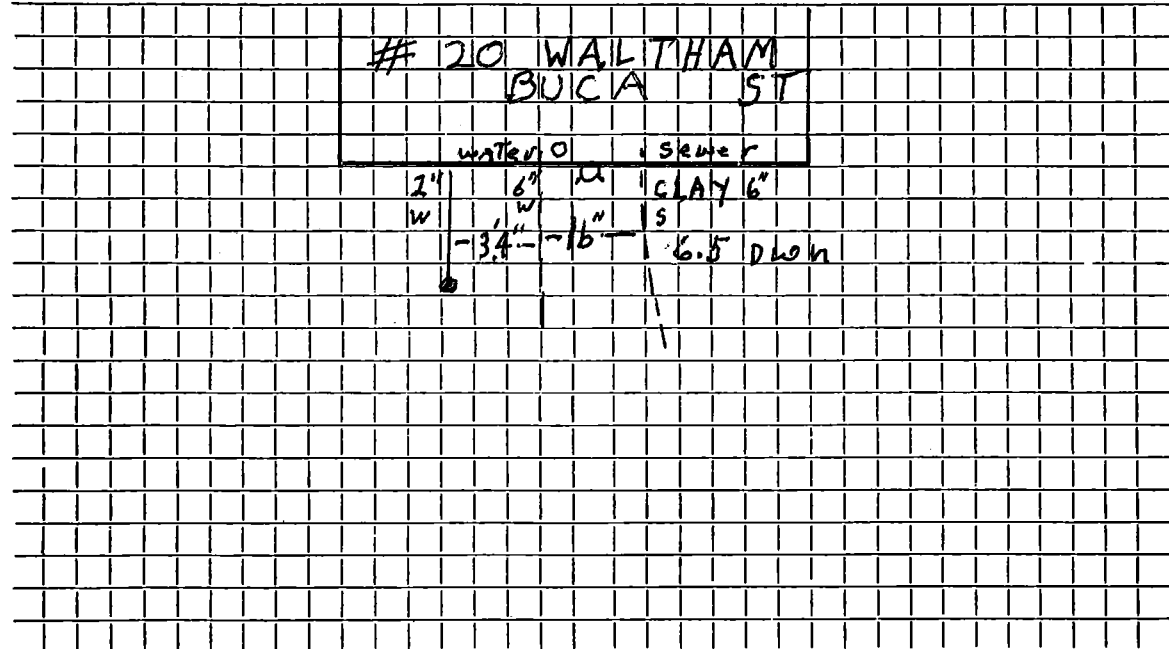

Connection made in ..... Street. Work completed .....?

Remarks: Pipe Uncover & A.S.B./2011 - when water connected to new main.

.....

.....