

Service No. 36 247

Address 40 Waltham St.

200 Waltham Street Location 200 Waltham St.

Kind of Pipe

Size 6"

Size of Main 8"

Revised New Service

Trench dug by owner

Location

Date	Material	Amount	Total	Date	Amount
4/30/29	2 Hrs. Labor @ .60	1.20			
P. 8.6-29 4.00 3.78	15% Overhead	.18	1.38		
4/30/29	8' 6" Sewer Pipe @ .30	2.40	2.40		
			3.78	Sept. 3 1929 - Cash	3.78

Labor

TOWN OF LEXINGTON—BOARD OF PUBLIC WORKS

SEWER DIVISION

DATE _____

NO. _____


The undersigned applies for the construction of a particular sewer connecting No. 56 Hatham St. Street and hereby agrees to comply with the Rules and Regulations governing the construction and use of Particular Sewers, as now or at any future time established by the Board of Selectmen.

Am't. of Estimate \$ _____

Am't. Paid \$ _____

Owner

Sketch of Service Here

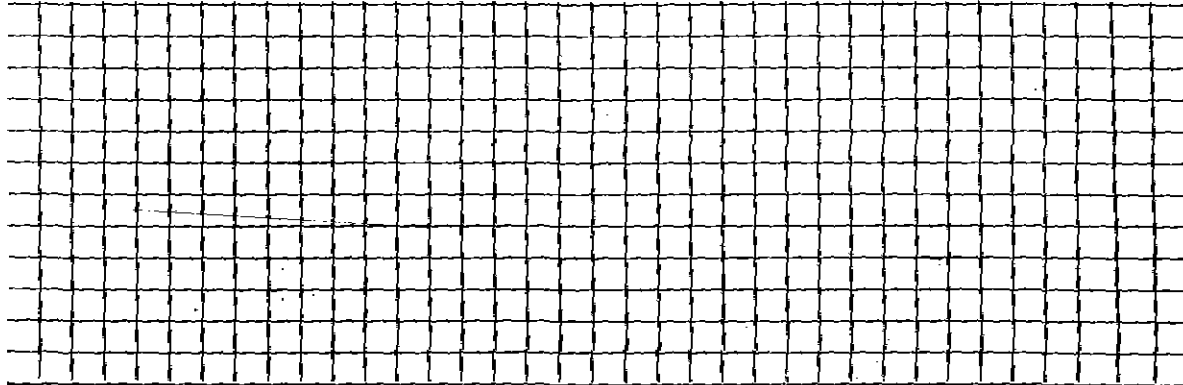

Connection made in _____ Street.

Work completed _____ 19

Remarks: