

Name John O'Connor

Service No. 78 1025

Address 201 Waltham Street

Lexington, Mass. 201 Waltham St Location 201 Waltham Street

Kind of Pipe

Size 6"

Size of Main 8"

~~Repair~~ Demand - New Service

City 12-9-46

Location

Date	Material	Amount	Total	Date	Location	Amount
June 24, '46	Labor	83 05	83 05	June 1, 46	Deposited	125 00
	10% Overhead		8 31	Dec 19, 46	Refunded	10 61
	58' - 6" Sewer Pipe @.256		14 85			114 39
	10' - 4" Soil Pipe @.50		5 00			
	Joint Compound		1 68			
	Trucking 2 hrs. @.75		1 50			
			114 39			
	Labor					

TOWN OF LEXINGTON—DEPT. OF PUBLIC WORKS
SEWER DIVISION

DATE

NO.


The undersigned applies for the construction of a particular sewer connecting No.
 Street and hereby agrees to comply with the Rules and Regulations governing the construction and use of Particular
 Sewers, as now or at any future time established by the Board of Selectmen.

Am't of estimate \$.....

Am't Paid \$.....

..... Owner

Sketch of Service Here

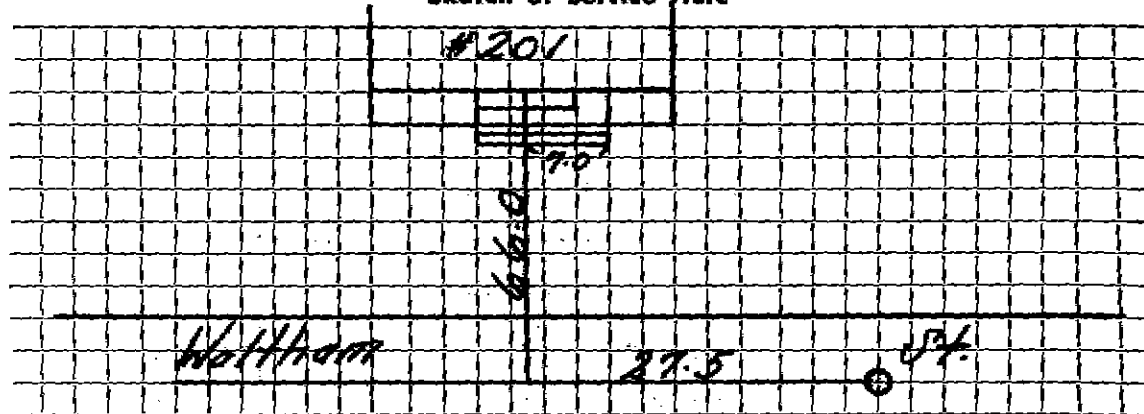

Connection made in Street.

Work completed 19..

Remarks: