

Name

Service No. 2572

Address 217 Waltham St

Location

lot 226

Kind of Pipe

Size

Size of Main

Repair—Renewal—New Service

J. McLaughlin

Location


Date	Material	Amount	Total	Date	Amount
8/29/07	6' 4" PVC				
	34' 6" PVC				
	1 4x6 Ferroco				
	1 6" PVC X PVC Ferroco	4' DWN			
	BACK of sidewalk				
10/5/88	16' 6" PVC Renewal T-MAIN				
	1 8" 8x6" Tee @ MAIN				
	1-6 90° bend				

DATE _____

TOWN OF LEXINGTON — BOARD OF PUBLIC WORKS

SEWER DIVISION

Sketch of Service Here

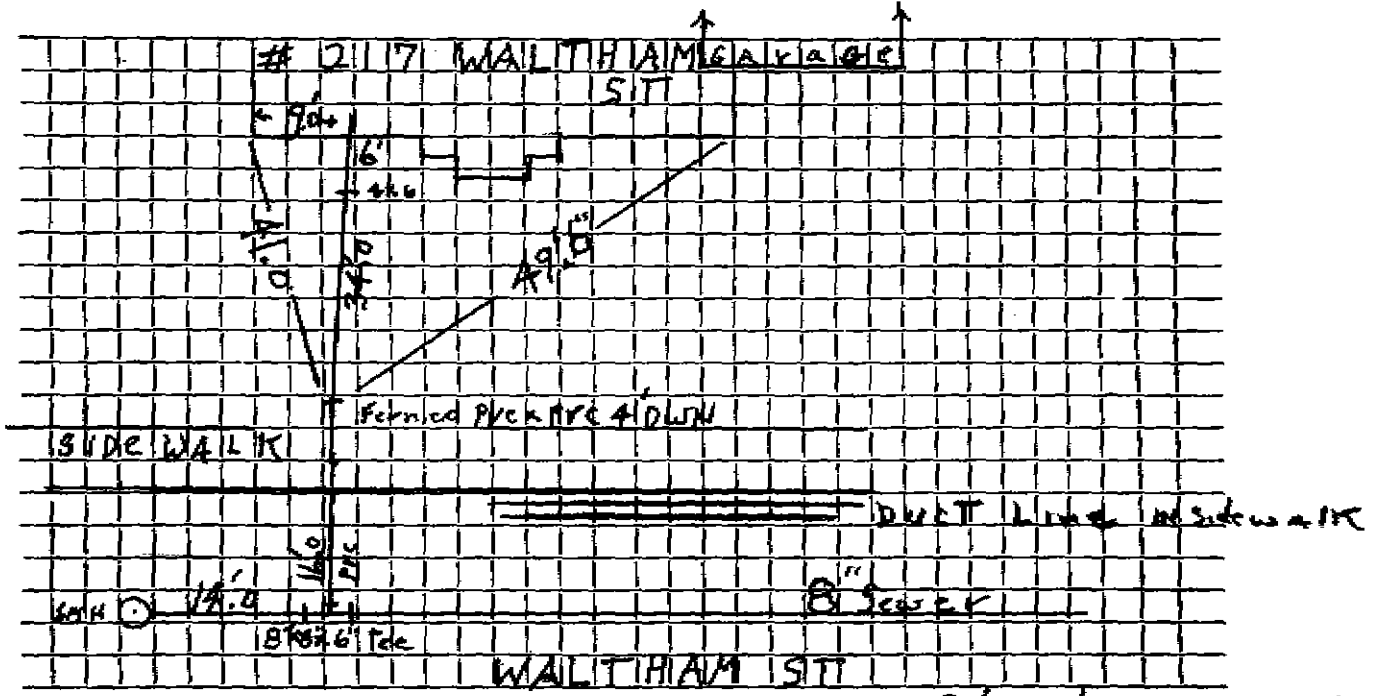

Connection made in _____ Street. Work completed 8/29/07 J plc

Remarks: Water may be in same trench same elev. part of the way
? There MAY be clay pgs under duct line