

TOWN OF LEXINGTON - BOARD OF PUBLIC WORKS

SEWER DIVISION

DATE 10-19-40

Corner of Wintthrop Rd


NO. _____

The undersigned applies for the construction of a particular sewer connecting No. Waltham St Street and hereby agrees to comply with the Rules and Regulations governing the construction and use of Particular Sewers, as now or at any future time established by the Board of Selectmen.

Am't. of Estimate \$ 65⁰⁰ - Town

Am't. Paid \$ _____

Arthur St Bourque owner

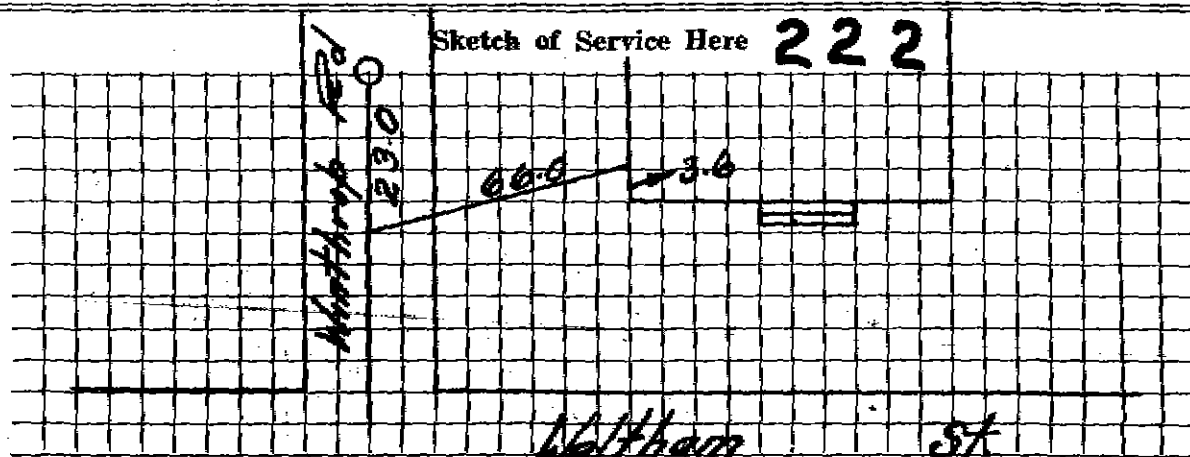

Connection made in _____

Street.

Work completed _____

19

Remarks: