

Name Moore Homes, Inc.

Service No.

Address 229 Waltham Street

229 Waltham Street

Location

Kind of Pipe

Size 6"

Size of Main 8"

~~Report~~ ~~Renumerate~~ New Service #4010 J. A. Cataldo Corp.

Location

Date	Material	Amount	Total	Date	Material	Amount
4/17/85	2 16' 6" PVC					
	1 Manhole					
	1 Frame & Cover					
	1 Wye					
	2 1/16 Bends				OUTSIDE	
				4/17/85	81' 6" PVC	
					10' 4" PVC	
					1 4" - 6" ferroce	
					1 Manhole	
					1 Frame & cover	


DATE _____

TOWN OF LEXINGTON — BOARD OF PUBLIC WORKS

SEWER DIVISION

Sketch of Service Here

229

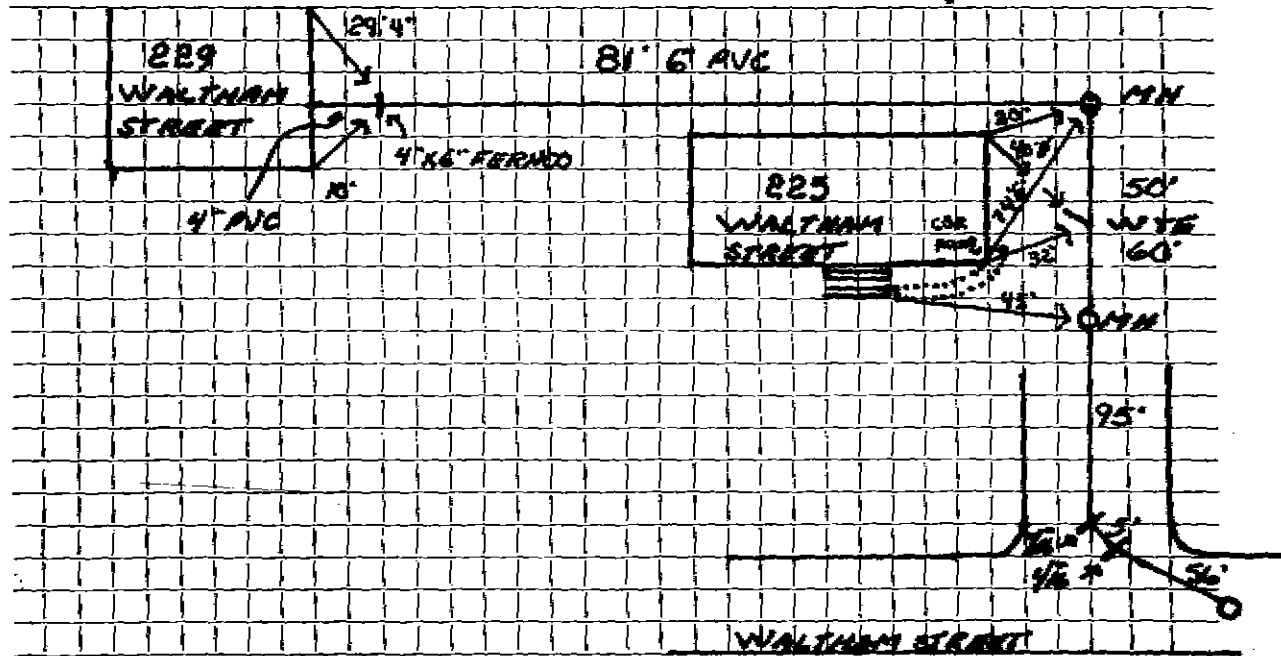

Connection made in Street. Work completed

Remarks:

.....