

Name Leonard Calwell

Service No. 138

Address 248 Waltham Street

248 Waltham Street

Location

Kind of Pipe

Size 6"

Size of Main 8"

~~Work Request~~ New Service

Location *Comm 12-31-58*

Date	Material	Amount	Total	Date	Amount
8-13-58	Labor	57.09		8-13-58	150.00
	10% O.H.	5.71	62.80	12-31-58	28.90
54'	6" Transite pipe @.70		37.80		121.10
2	hrs. Town Shovel @6.50		13.00		
2	hrs. Trucking @.75		1.50		
1	hr. Trucking @3.00		3.00		
1	hr. Rodgers Trailer @ 3.00		3.00		
			121.10		
	Labor				

TOWN OF LEXINGTON—DEPT. OF PUBLIC WORKS
SEWER DIVISION

DATE.....

NO.....


The undersigned applies for the construction of a particular sewer connecting No.....
Street and hereby agrees to comply with the Rules and Regulations governing the construction and use of Particular
Sewers, as now or at any future time established by the Board of Selectmen.

Am't of estimate \$.....

Am't Paid \$.....

..... Owner

Sketch of Service Here

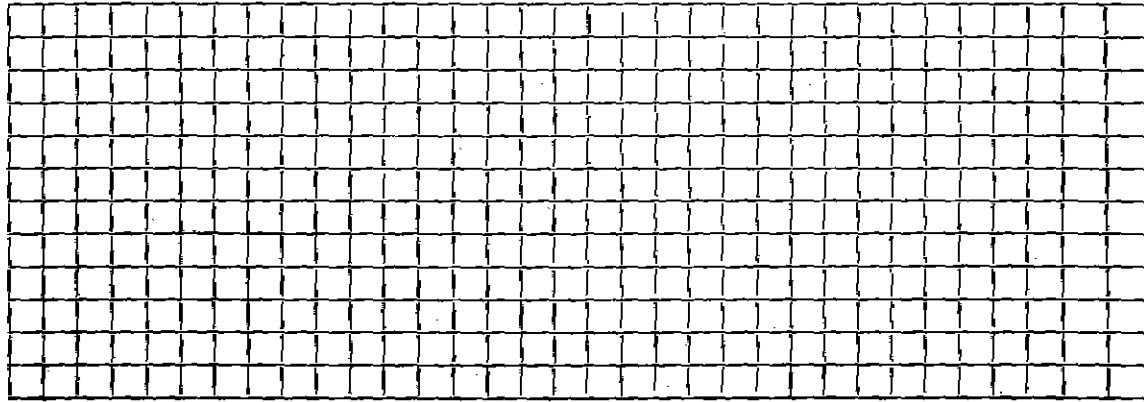

Connection made in..... Street.

Work completed.....19..

Remarks: