




DATE \_\_\_\_\_

TOWN OF LEXINGTON — BOARD OF PUBLIC WORKS

SEWER DIVISION

Sketch of Service Here

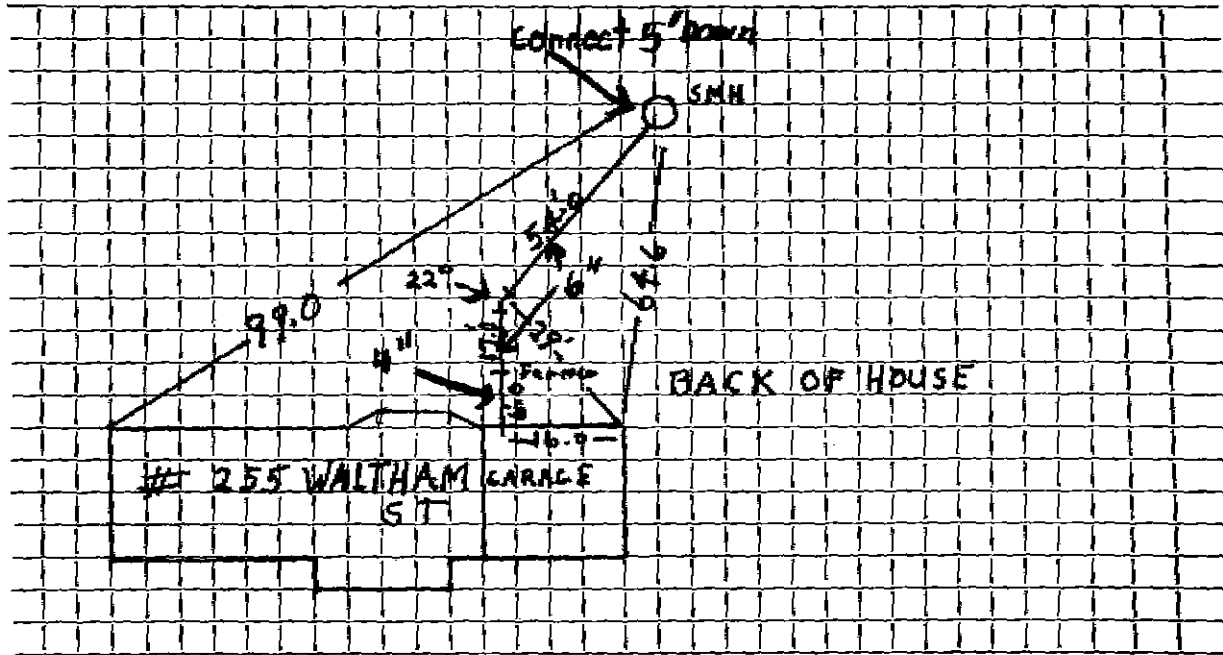

Connection made in *High School Y.D.* Street. Work completed .....

Remarks: .....  
.....  
.....