


Inspected

DATE 5/6/14

TOWN OF LEXINGTON — BOARD OF PUBLIC WORKS SEWER DIVISION

Sketch of Service Here

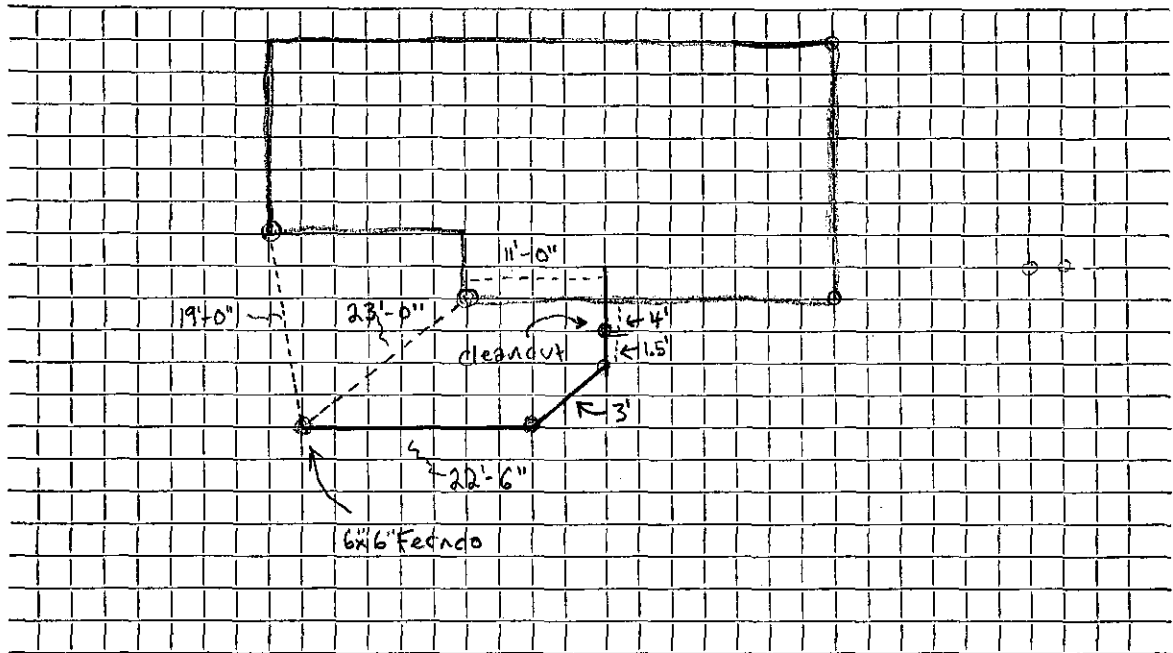

Connection made in 267 Waltham St Street. Work completed

Remarks:
.....
.....