


DATE _____

TOWN OF LEXINGTON — BOARD OF PUBLIC WORKS

SEWER DIVISION

Sketch of Service Here **287**

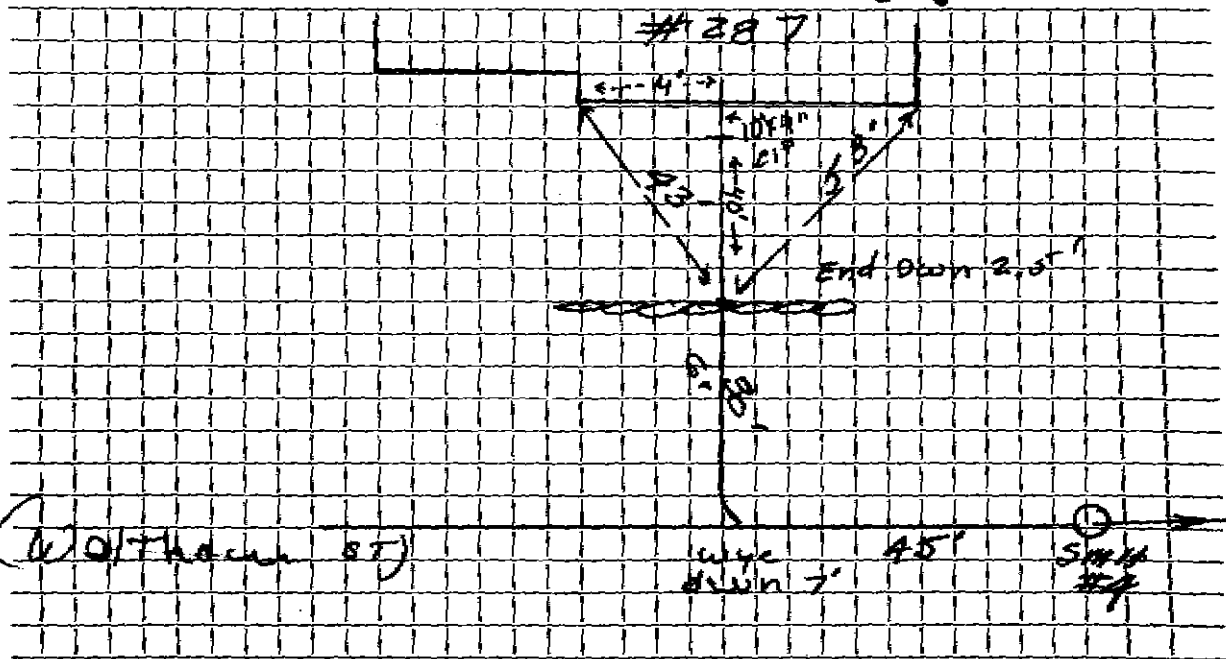

Connection made in ... Waltham ... Street. Work completed

Remarks: 8' of 6" DE & 22' of 6" APP (= 30') was used.