

Name William D. Fitzgerald

Service No. 36

Address #292 WALTHAM ST

292 Waltham Street

Location

Kind of Pipe ACP + PVC

Size 6"

Size of Main 8" ACP

~~Repair~~ ~~Renewal~~ ~~New Service~~ Valeri #4185

Location FEB 24 1986


Date	Material	Amount	Total	Date		Amount
7/12/79	23' OF 6" ACP @	\$17.00/ft =	\$391.00	10-16-85	Deposit	391.00
12/16/85	30' x 6" P.V.C.					
	10' x 4" C.I.P.					
	1 45° Elbow					
	1 22½° Elbow					
	1 6" P.V.C. x A.C.P. Adaptor					
	1 6" x 4" Donut					

DATE AUGUST 1979

TOWN OF LEXINGTON — BOARD OF PUBLIC WORKS

SEWER DIVISION

Sketch of Service Here **292**

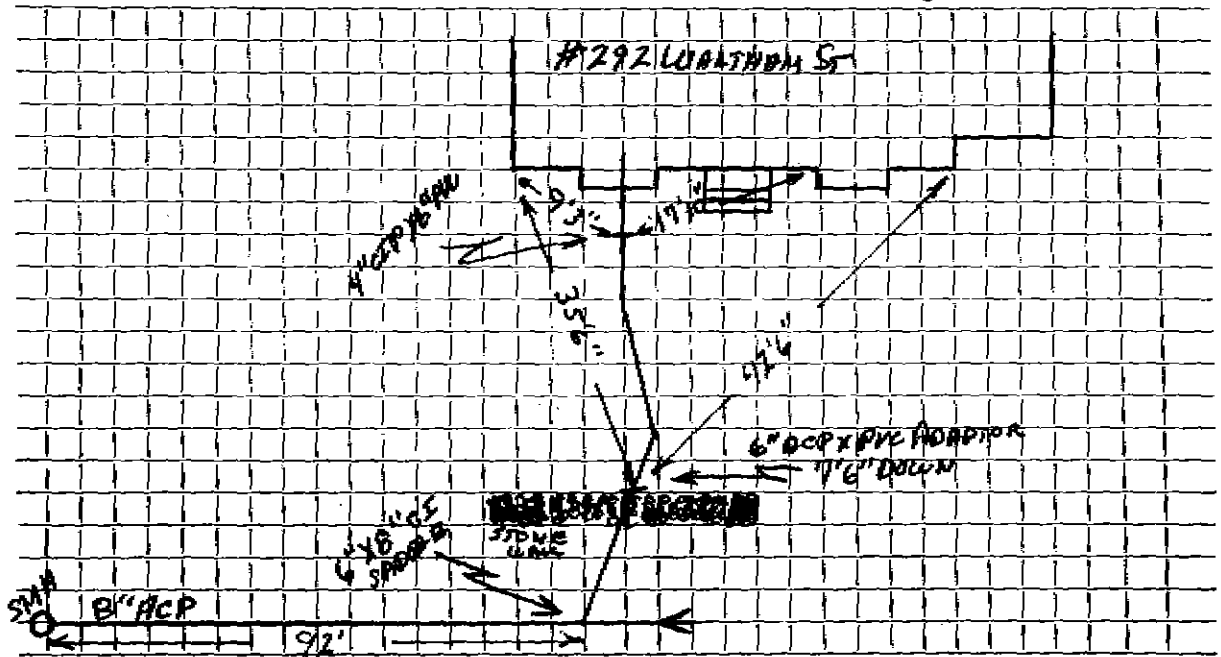

Connection made in WALTHAM ST Street. Work completed DEC. 16, 1985

Remarks: