

Name James Benfro

Service No. 29

Address #295 Waltham St  
295 Waltham Street

Location

Kind of Pipe ACP S D I

Size 6"

Size of Main 8"

REPAIRS - New Service Eagle #3504A

Location AUG 4 1980

Date	Material	Amount	Total	Date	Location	Amount
7/10/79	18' of 6" DI @ 17.00/FT	17.00	646.00	7-30-80	Deposit	646.00
	20' of 6" AC @ 17.00/FT	17.00				
	INSIDE					
	15' CAST IRON PIPE					
	65' 2400 TRANSITE PIPE					


DATE \_\_\_\_\_

TOWN OF LEXINGTON — BOARD OF PUBLIC WORKS

SEWER DIVISION

Sketch of Service Here

295

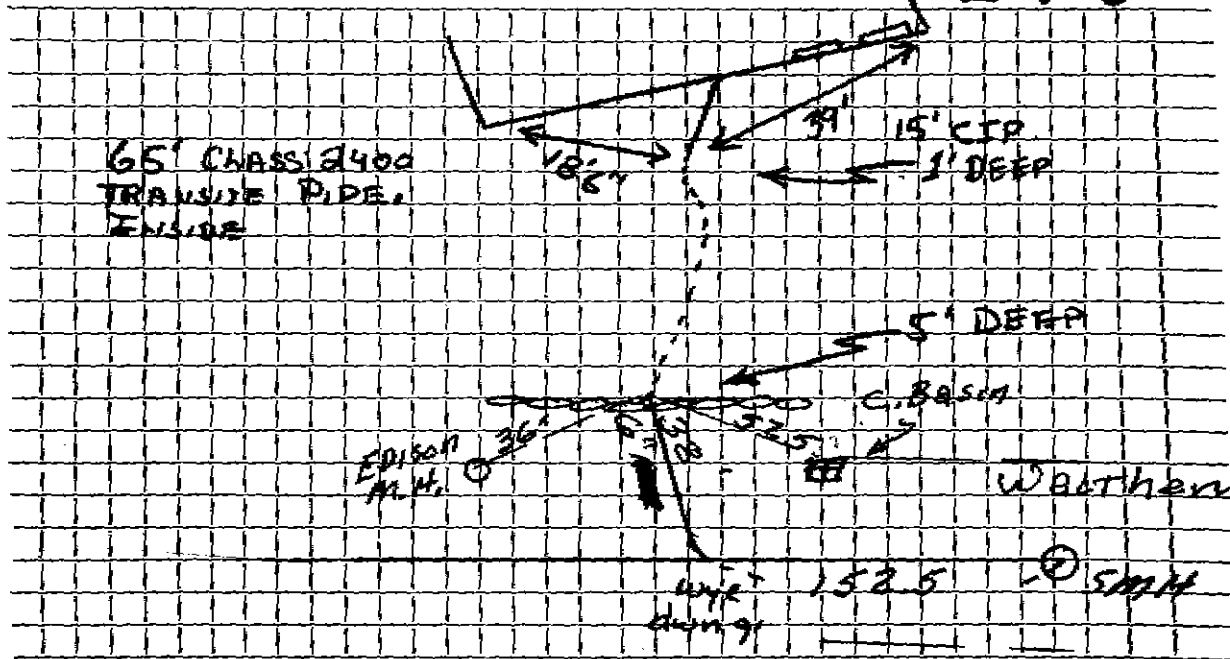

Connection made in ~~Waltham~~ Waltham Street. Work completed .....

Remarks: 18' of 6" Ductile & 20' of 6" ACP. WAS. used. (= 38')