

Name William Sartanowicz

Service No. 56

Address 300 Waltham Street

300 Waltham Street

Location

Kind of Pipe ACP

Size 6"

Size of Main 8"

~~Replacement~~ New Service Valeri #4498

Location FEB 27 1984

| Date     |     | Material         | Amount | Total    | Date    | Amount  |
|----------|-----|------------------|--------|----------|---------|---------|
| 7/18/79  | 21' | 6" ACP @ \$17.00 |        | \$357.00 | 11-7-83 | Deposit |
| 11/23/83 | 95' | 6" P.V.C.        |        |          |         | 357.00  |
|          | 1   | Brick M.H.       |        |          |         |         |
|          | 4   | 22° Elbows       |        |          |         |         |
|          | 1   | 22° Sweep        |        |          |         |         |
|          | 1   | Feruco AC to PVC |        |          |         |         |
|          |     | 4" x 6" Donut    |        |          |         |         |
|          | 30' | 6" PVC           |        |          |         |         |
|          | 7½' | 4" Cast          |        |          |         |         |
|          |     | 4" x 6" Donut    |        |          |         |         |


DATE \_\_\_\_\_

TOWN OF LEXINGTON — BOARD OF PUBLIC WORKS

SEWER DIVISION

Sketch of Service Here

300

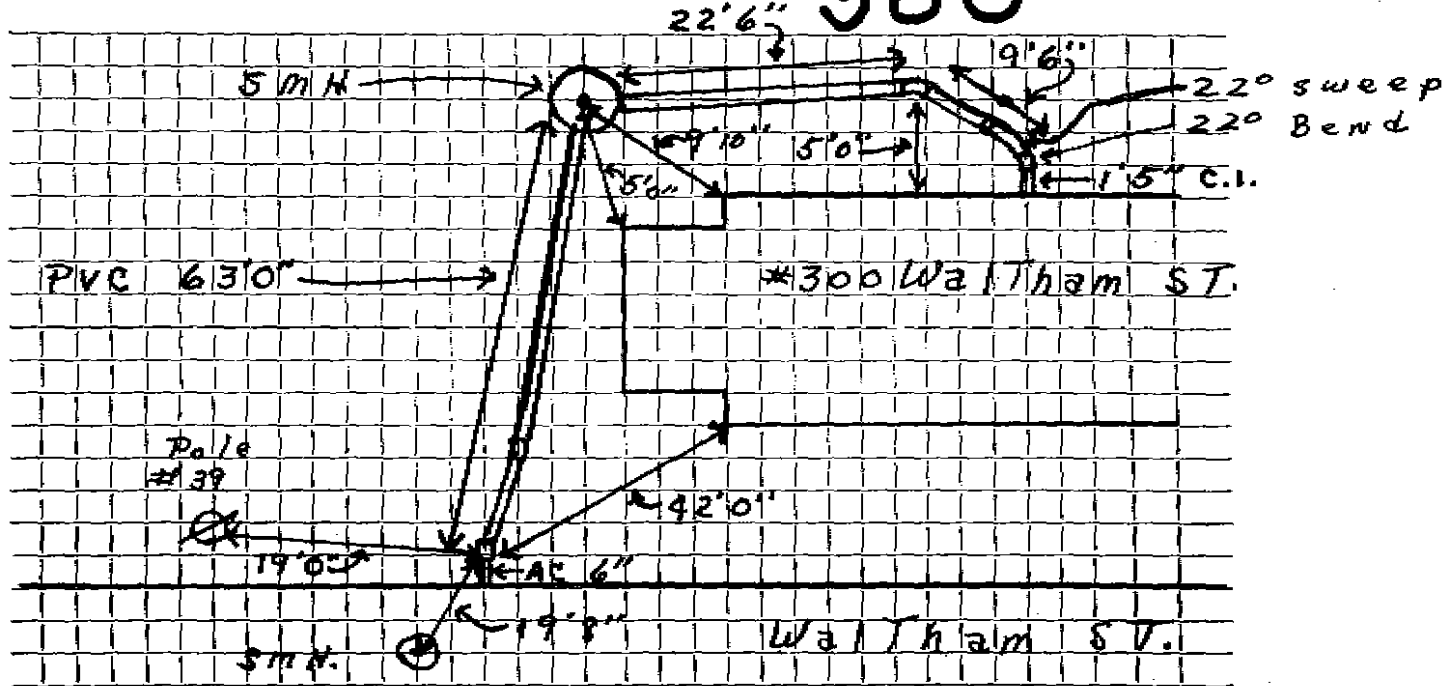

Connection made in ..... Street. Work completed .....

Remarks: .....

.....

.....