

WATER SERVICE RECORD

Name Carmin Salvucci

Service No. 38

Address 305 Waltham Street

Location

Repair—Renewal—New Service W.O.#5049 Lexington Sewerage#740

MAR 18 1968


Date	Material	Amount	Total	Date	Amount
8-14-67	120' 3/4" Copper tubing			7-7-47	250 00
				3-18-68	10 72
7/17/67	Labor 106.36				239 38
8/17/67	" 8.02				
8/17/67	" 13.79	128 17			
	10% O.H.	<u>2 81</u>	140 98		
	33'-3/4" copperpipe @.79		26 07		
	1- 3/4" corp.		7 42		
	1- 3/4" curb cock		8 76		
	Box & rod		5 10		
	500 lbs cold patch		1 45		
	2 Ton hot top @ 6.50		13 00		
	3 Hrs. trucking @ 3.00		10 50		
	3 " shovel @ 6.50		19 50		
	1 " compressor @ 5.00		5 00		
	1/2 " roller @ 3.00		1 50		
			<u>239 28</u>		

DATE _____

TOWN OF LEXINGTON — BOARD OF PUBLIC WORKS

WATER DIVISION

Sketch of Service Here

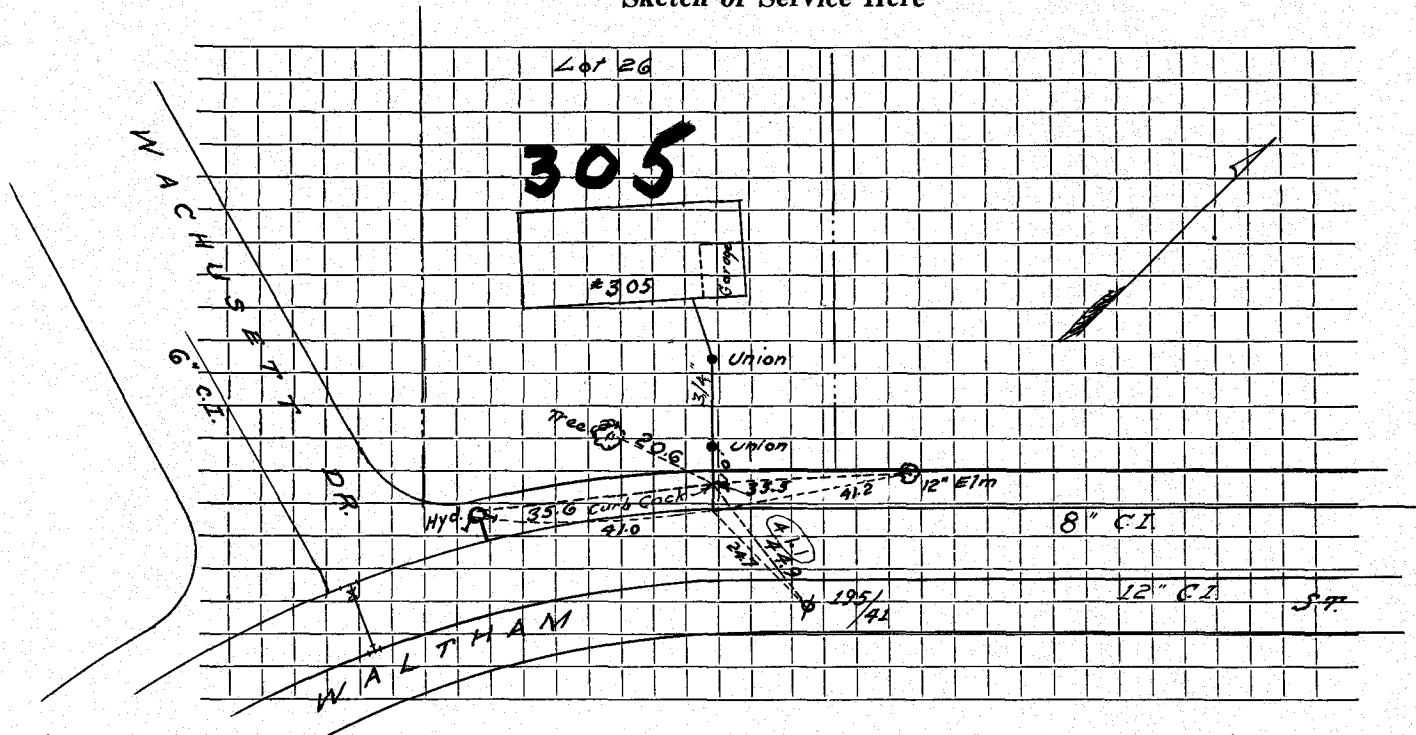

Connection made in Street. Work completed

Remarks:
.....
.....