

Name **Manhattan Builders**

Service No. 201

Address **31 Waltham Street****31 Waltham Street**

Location

Kind of Pipe

Size **6"**Size of Main **8"**~~XXXXXXXXXXXX~~ **New Service DeFlice Bros. Permit #A-152 W.O.#1170**Location **MAR 14 1966**


Date	Material	Amount	Total	Date	Amount
.14-65	Labor 88.71			12-9-65	300 00
.15-65	Labor 75.39			4-15-66	22 90
.16-65	Labor 57.30	221 40			322 90
	10% O.H.	22 14	243 54		
20'	6" Transite pipe @.82		16 40		
2	Doz. Brick @ 4.20 per 100		1 01		
1	Bag Cement		1 50		
12	Ton Gravel @		13 20		
3	Hrs Shovel @ 6.50		19 50		
1½	Hr. Tractor @ 6.50		9 75		
2	Hrs. Town Truck @ 3.00		6 00		
2	Hrs. Compressor @ 5.00		10 00		
½	Hr. Loader @ 4.00		2 00		
			322 90		Bill sent 22 90
-65	10' 6" Transite pipe				

DATE _____

TOWN OF LEXINGTON — BOARD OF PUBLIC WORKS
SEWER DIVISION

Sketch of Service Here

31

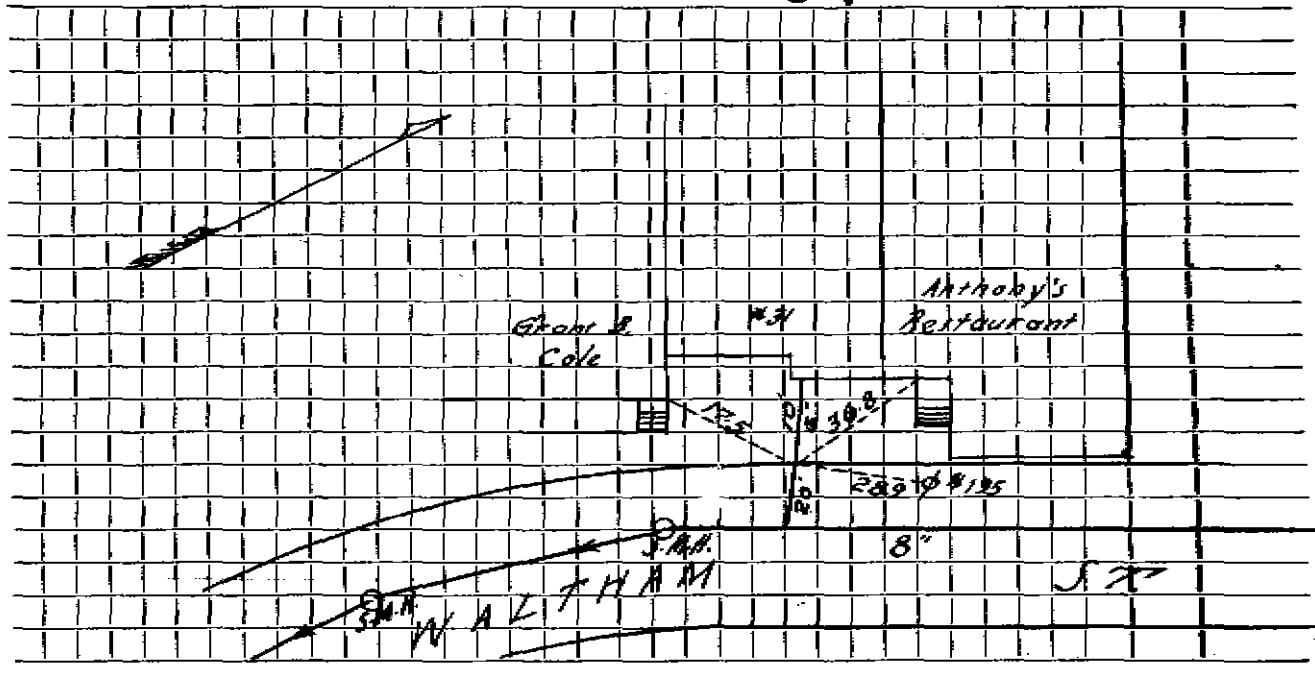

Connection made in Street. Work completed

Remarks:
.....
.....