


DATE _____

TOWN OF LEXINGTON — BOARD OF PUBLIC WORKS

SEWER DIVISION

Sketch of Service Here **312**

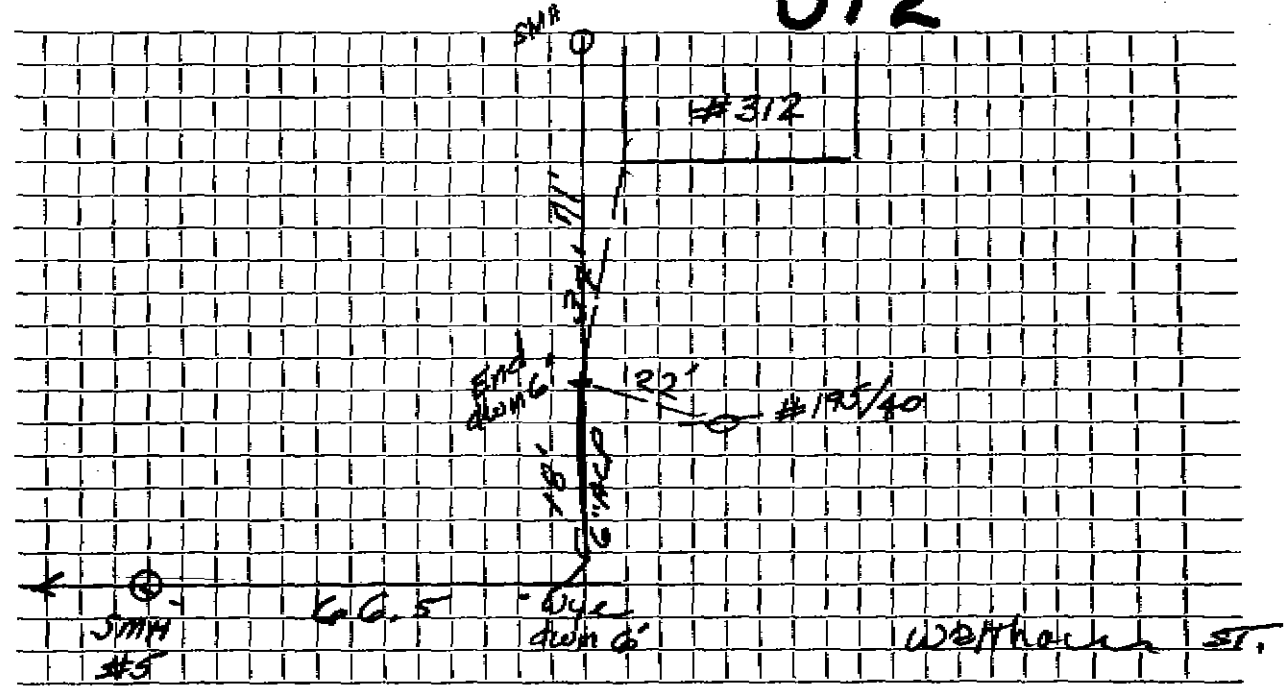

Connection made in Waltham Street. Work completed

Remarks: