




DATE 5/8/96

TOWN OF LEXINGTON — BOARD OF PUBLIC WORKS

SEWER DIVISION

Sketch of Service Here **326**

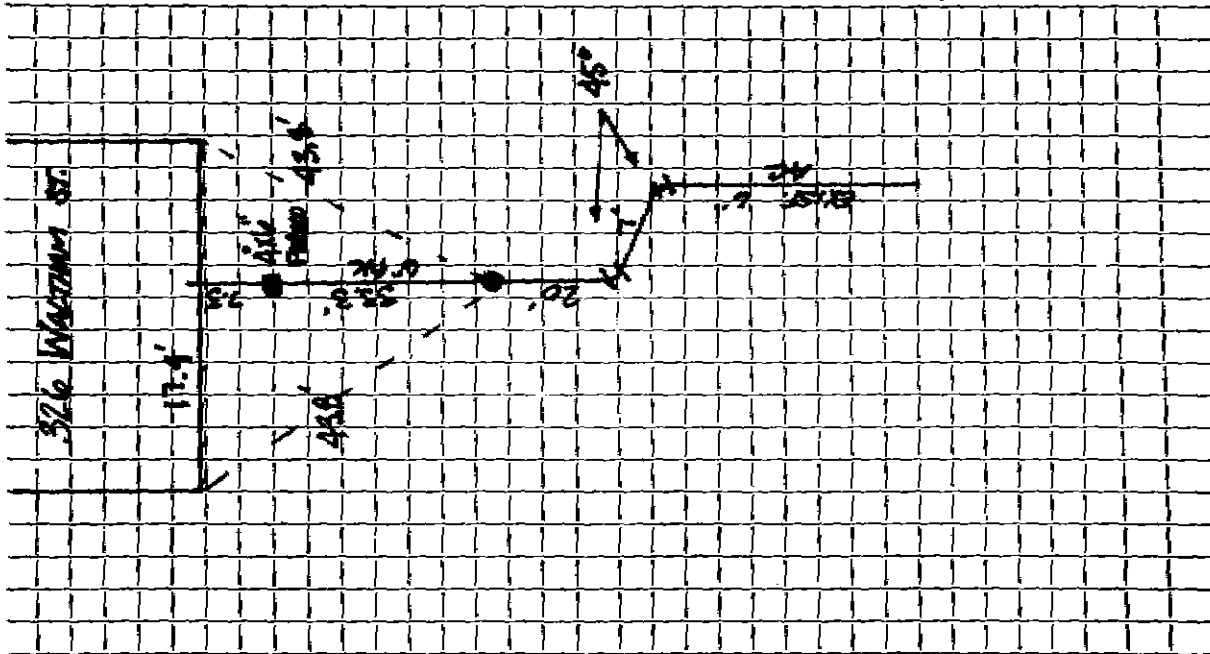

Connection made in ..... Street.

Work completed KIRKLAND & SHAW .....

Remarks: .....  
.....  
.....