




DATE 9/4/92

TOWN OF LEXINGTON — BOARD OF PUBLIC WORKS  
SEWER DIVISION

Sketch of Service Here **333**

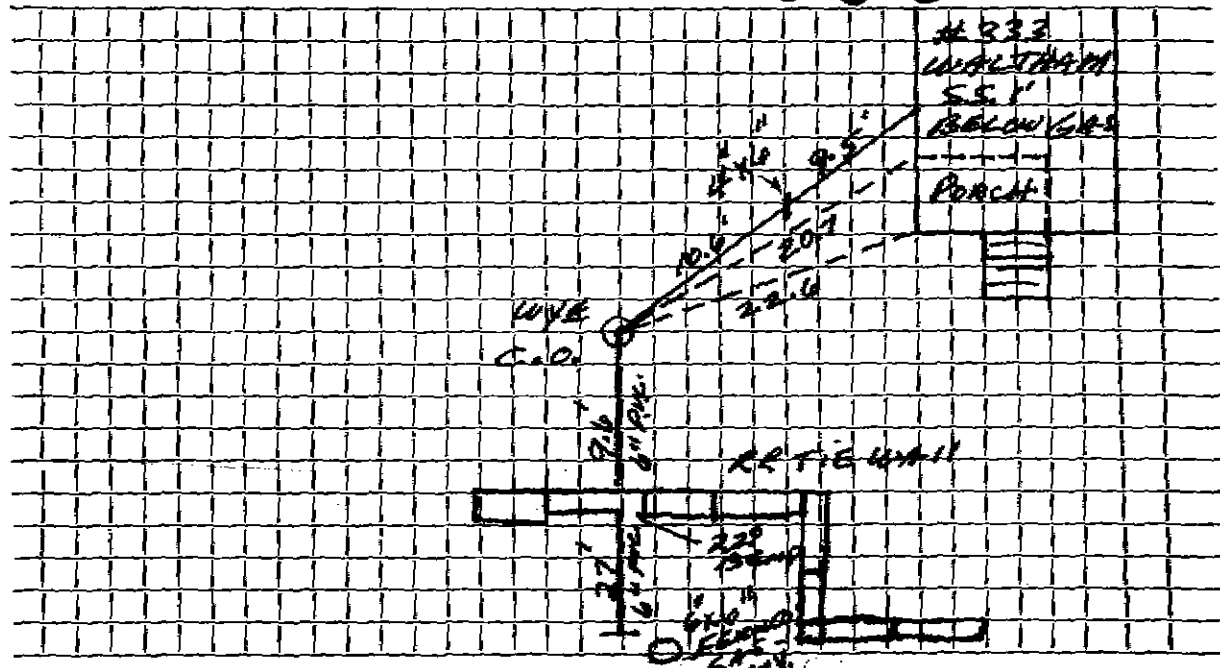

Connection made in #333 WALTHAM Street.

Work completed BY: B. MCKEE

Remarks: INSPECTED: GRG