

Name Victor Savchuk, Jr.

Service No. 31

Address 337 WALTHAM ST

337 Waltham Street

Location

Kind of Pipe 22' 6" AC & 18' 6" CI Size 6"

Size of Main 8"

~~Arlex Oil #4087~~ New Service Arlex Oil #4087

Location MAR 14 1983


Date	Material	Amount	Total	Date	Amount
7/26/79	22' 6" AC	@ 17.00 =	374.00	11/11/82	Deposit 680.00
	18' 6" CI	@ 17.00 =	306.00		
			680.00		
10/22/82	36' x 6" PVC				
	1 45° PVC ELBOW				
	1 O Ring				

DATE _____

TOWN OF LEXINGTON — BOARD OF PUBLIC WORKS

SEWER DIVISION

Sketch of Service Here **337**

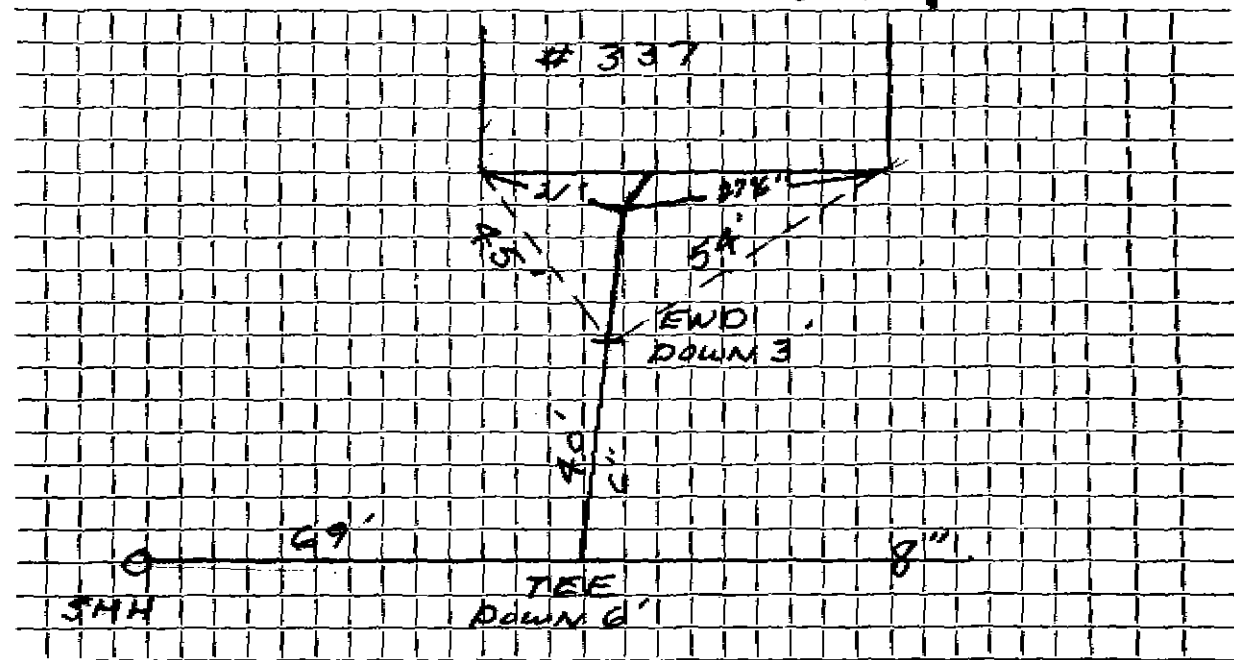

Connection made in WALTHAM Street. Work completed 7/26/79

Remarks:

.....

.....