

Service No.

Name James Mahoney

Address 342 Waltham St. Lex

342 Waltham Street Location

Kind of Pipe 6" PVC + 4" SCH 40 Size 6" Size of Main 8"


Repair—Renewal—New Service Bruce McKee Location

Date	Material	Amount	Total	Date	Amount
5/12/95	23'-6" PVC				
	10' SCH 40 - 4"				
	1- 4X6 FENCO				
	1- 6X6 FENCO TO AC PIPE				
7-24-79					
19'	6" AC PIPE 5' DEEP				

DATE

TOWN OF LEXINGTON — BOARD OF PUBLIC WORKS

SEWER DIVISION

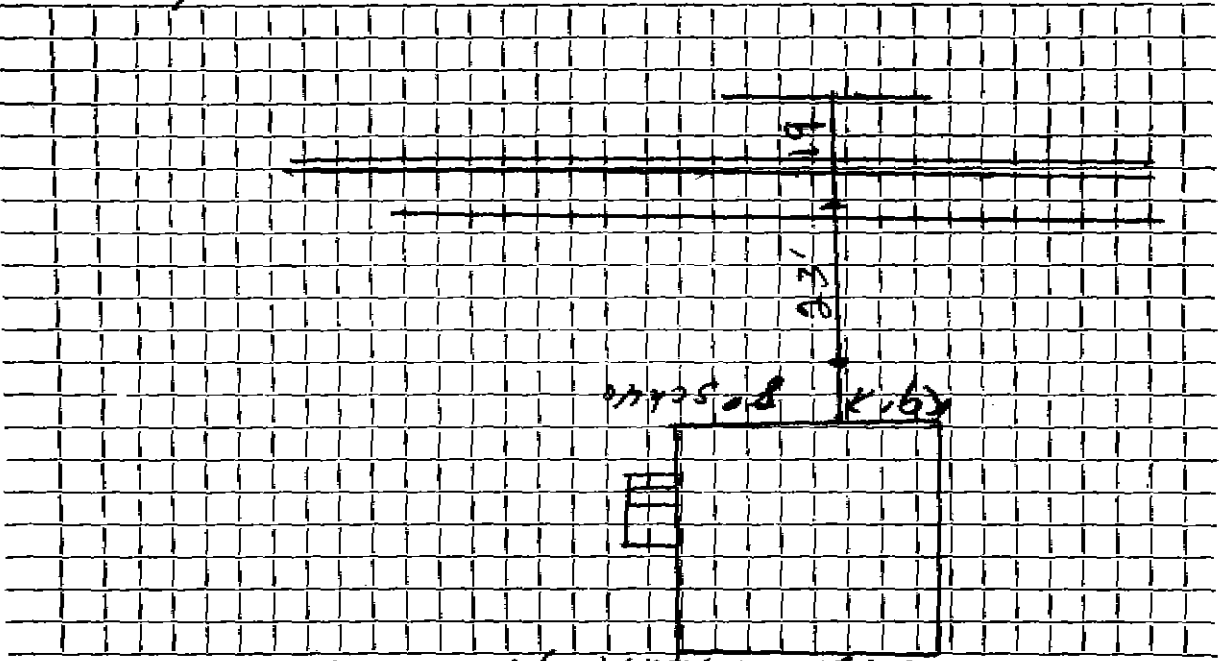

342 WALTHAM ST.
Sketch of Service Here
342

Connection made in

Street.

Work completed

5/12/95
BRUCE J. MCKEE

Remarks: