

Service No.

Name Thomas Todd
 Address 345 WALTHAM ST.

345 Waltham Street

Location
 Size 6" Size of Main 8"

Kind of Pipe
 Repair—~~Renewal~~ New Service McKee #0648 Location

Date	Material	Amount	Total	Date	Amount
10-28-72	107.5 LF 6" PVC			10-27-72	646.00
	3 LF 9" CI				
	6 LF 6" PVC				
	2" C. F. RANCO				
	3" C. F. RANCO				
	6" C. W. 9/8 EXHOUT				
	2" C. W. 9/8				
	2" C. W. 9/8				
	2" C. W. 9/8				
7/27/79	16' 6" AC				
	22' 6" C.I.	\$517.00	\$646.00		


TOWN OF LEXINGTON — BOARD OF PUBLIC WORKS

SEWER DIVISION

DATE _____

345

Sketch of Service Here

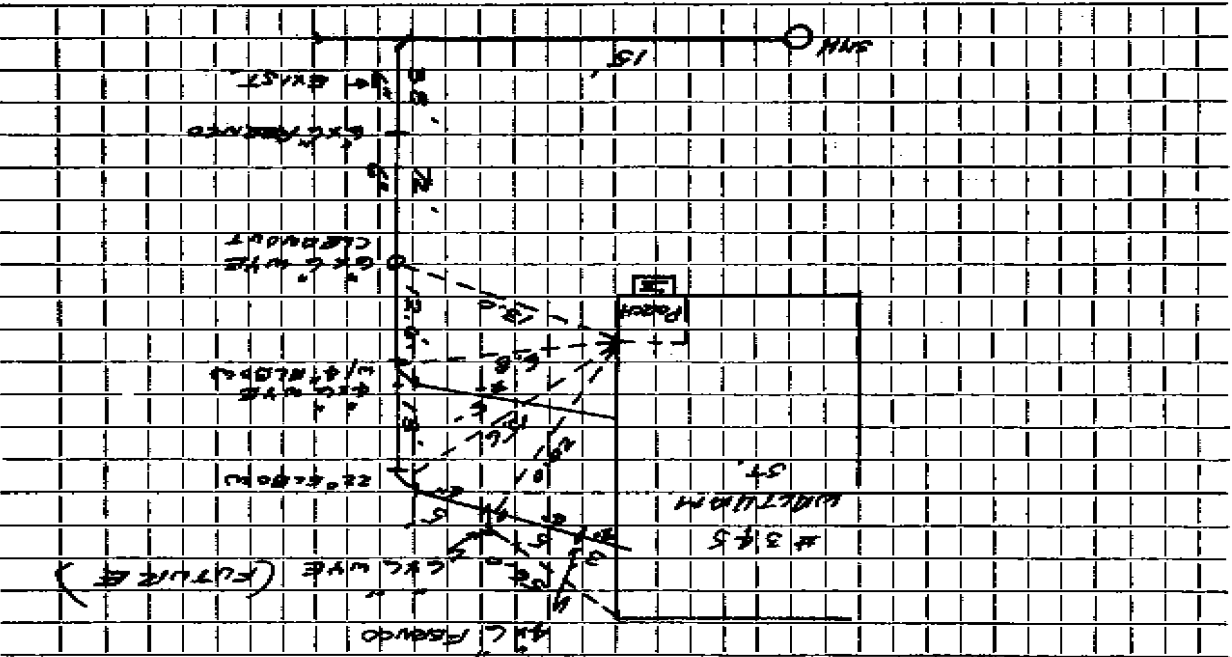

Street.

Work completed

WALTHAM ST.

Connection made in

Remarks: