

Name

Service No.

Address 346 Waltham St

346 Waltham Street

Location

Kind of Pipe Size 6"

Repair—Removal—New Service

Location

Size of Main 8"

Date	Material	Amount	Total	Date	Amount
7-29	1/2 ft. of 6" HD @ \$7.00/ft	# 23800			


Remarks:

Connection made in

WALHORN

Street.

Work completed

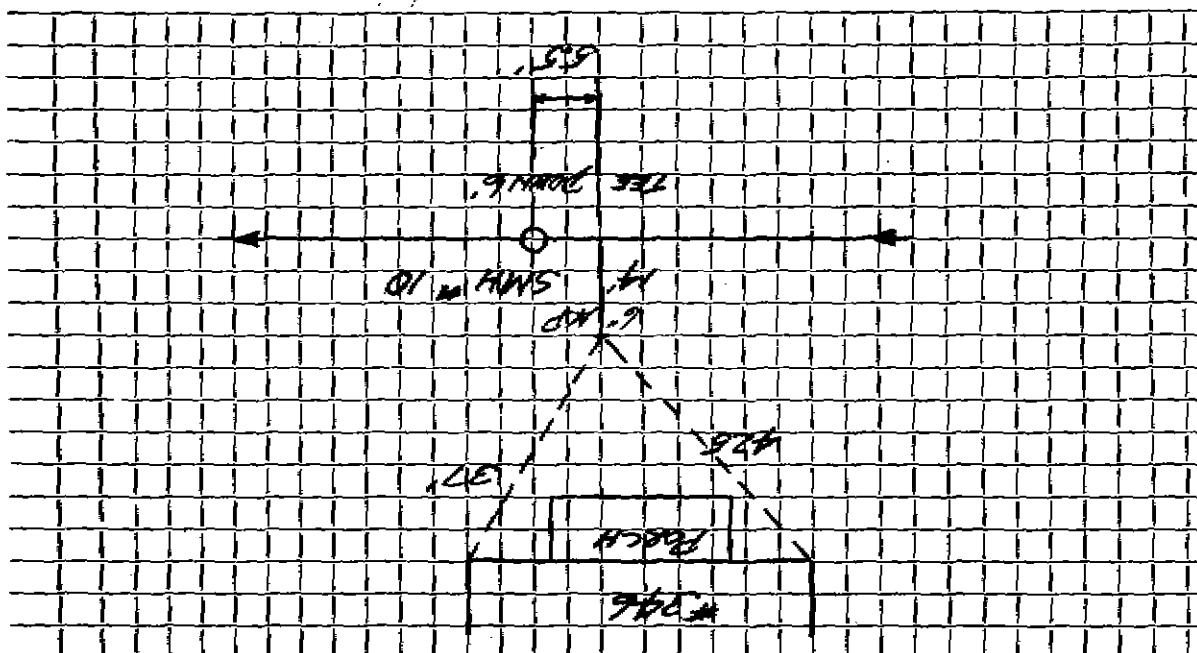

346

Sketch of Service Here

SEWER DIVISION

TOWN OF LEXINGTON — BOARD OF PUBLIC WORKS

DATE