

Name C.B. HOME BUILDERS, INC.

Service No.

Address # 354 WALTHAM STREET

354 Waltham Street

Location

Kind of Pipe

Size 6"

Size of Main 8"

Repair—Renewal—New Service

PERMIT NO. 0696 McLaughlin

Location


Date	Material	Amount	Total	Date	Amount
995	6'-4"				
	73'-6" PVC			7-24-79	
				19' 6" Transite	

DATE / SEPTEMBER 1995

TOWN OF LEXINGTON — BOARD OF PUBLIC WORKS
SEWER DIVISION

Sketch of Service Here

354

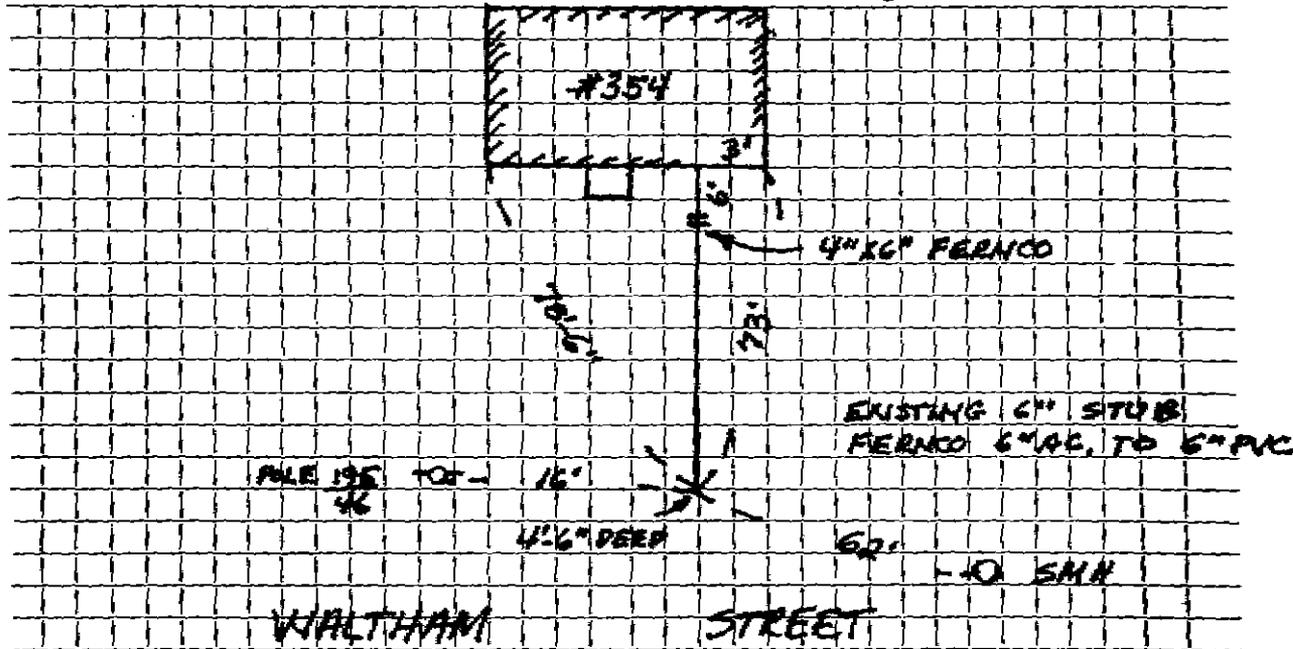

Connection made in WALTHAM STREET Street.

Work completed J.M. MCLAUGHLIN, INC.

Remarks:

BOOK 96A

J.W