


DATE 9/10/85

TOWN OF LEXINGTON — BOARD OF PUBLIC WORKS
SEWER DIVISION

Sketch of Service Here **360**

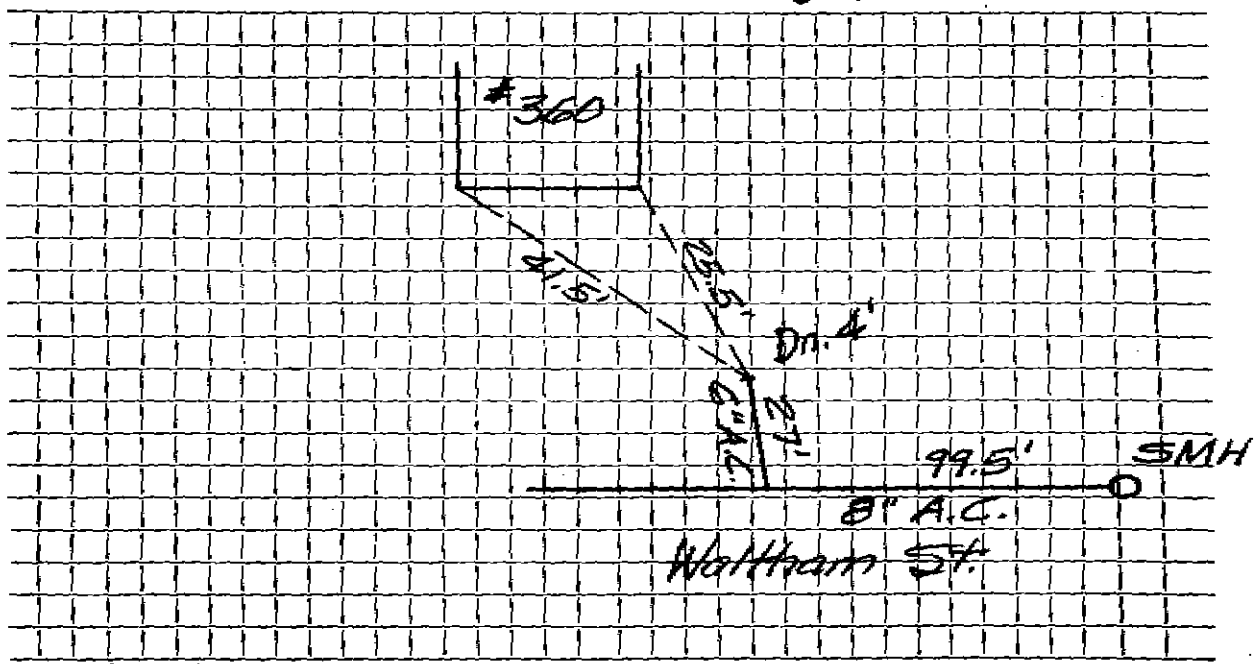

Connection made in Waltham Street. Work completed

Remarks: