

Name **Dianne Estates, Inc.**

Service No. **145**

Address **364 Waltham Street**

(3 Paul Revere Hi.,) 364 Waltham St. Location

Kind of Pipe

Size **6"**

Size of Main **8"**

~~REPAIRS~~ **New Service**


Location **Comm 12-4-61**

Date	Material	Amount	Total	Date	Amount	
0/18/61	Labor	67 83		12-11-61	Deposit	150 00
	10% O.H.	6 78	74 61	12-4-61	Paid by WHC #159	10 15
						160 15
	43 6" Transite Pipe @ .78		33 54			
	4 Hrs. Town Shovel @ 5.00		20 00		Non-Charge	
	3 Hrs. Trucking @ 3.00		9 00	10/18/61	Labor	16 08
	23 X 3 Patch		23 00			
			160 15		Shovel broken down.	
				8-29-00	Respond and measure	
				12-6-02	give 32' from new hole	

DATE _____

TOWN OF LEXINGTON — BOARD OF PUBLIC WORKS
SEWER DIVISION

Sketch of Service Here

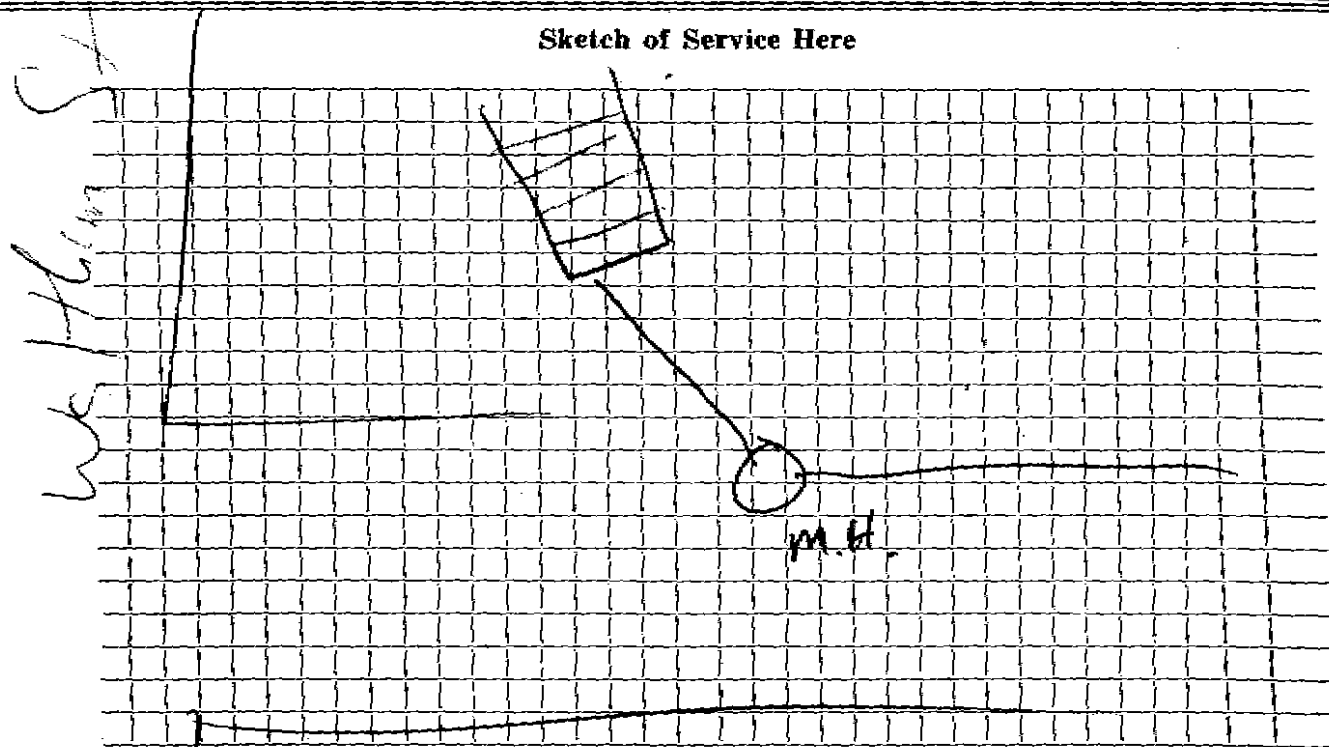

Connection made in _____ Street. Work completed _____

Remarks: SERVICE COMES OUT ONTO GRAPEVINE - CAN BE
flushed from manhole in street