


DATE 10-4-'90

TOWN OF LEXINGTON — BOARD OF PUBLIC WORKS
SEWER DIVISION

365

Sketch of Service Here

365 WALTHAM ST.

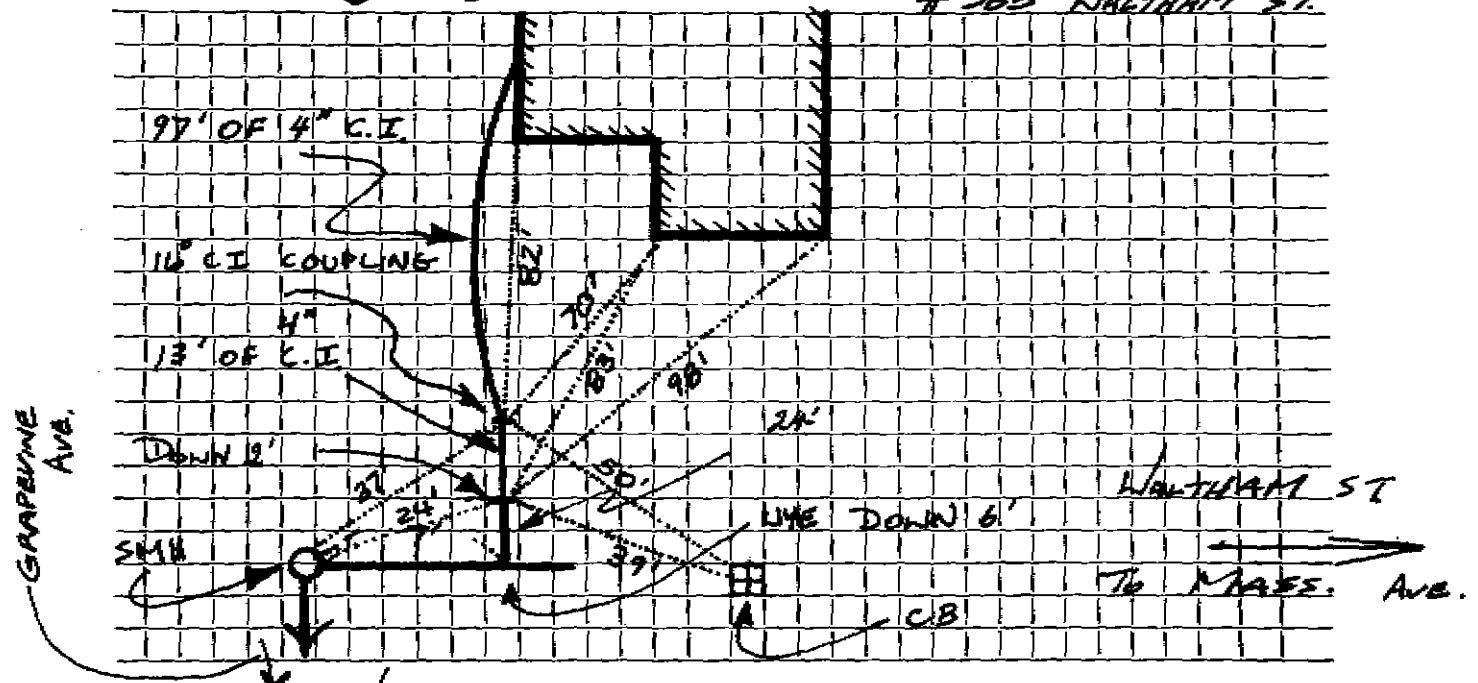

Connection made in WALTHAM Street. Work completed

Remarks: INSPECTED 10-4-'90 BY P. BARROWS CONTRACTOR S. REIDMAN