




DATE \_\_\_\_\_

# TOWN OF LEXINGTON — BOARD OF PUBLIC WORKS

## SEWER DIVISION

Sketch of Service Here

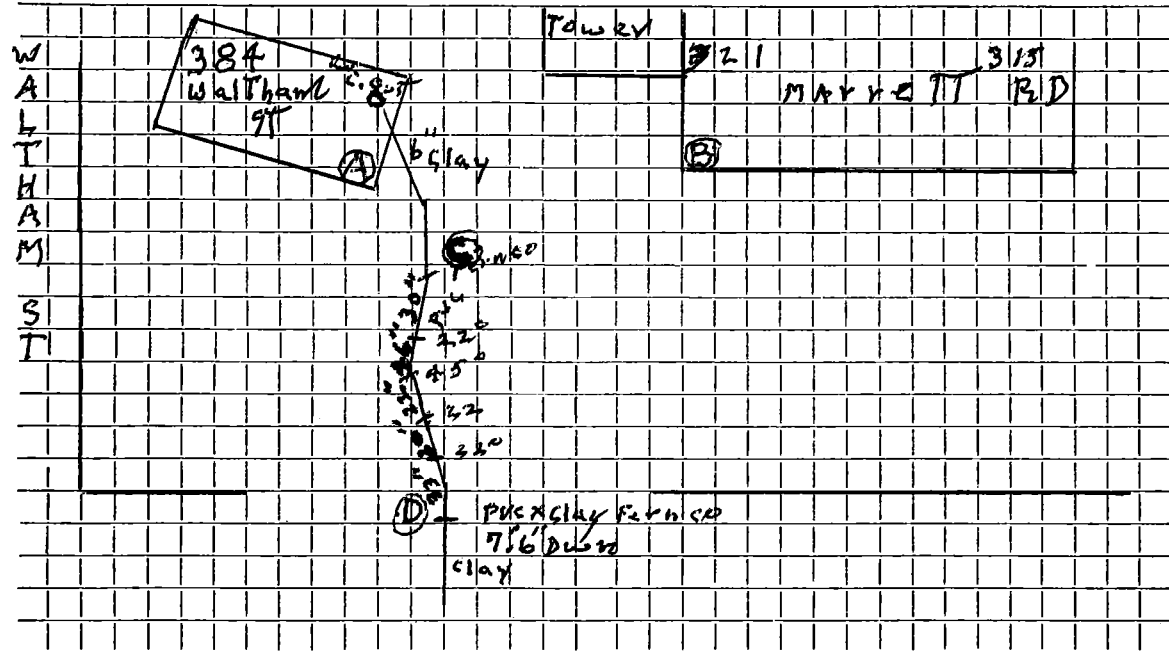

A-C	32'
B-C	34'
A-D	47'8"
B-D	48'

Connection made in Marvett Rd Street. Work completed .....

Remarks: This is Repair Midway 30.11 .....

.....