




DATE 9-13-'90

TOWN OF LEXINGTON — BOARD OF PUBLIC WORKS

SEWER DIVISION

Sketch of Service Here **396**

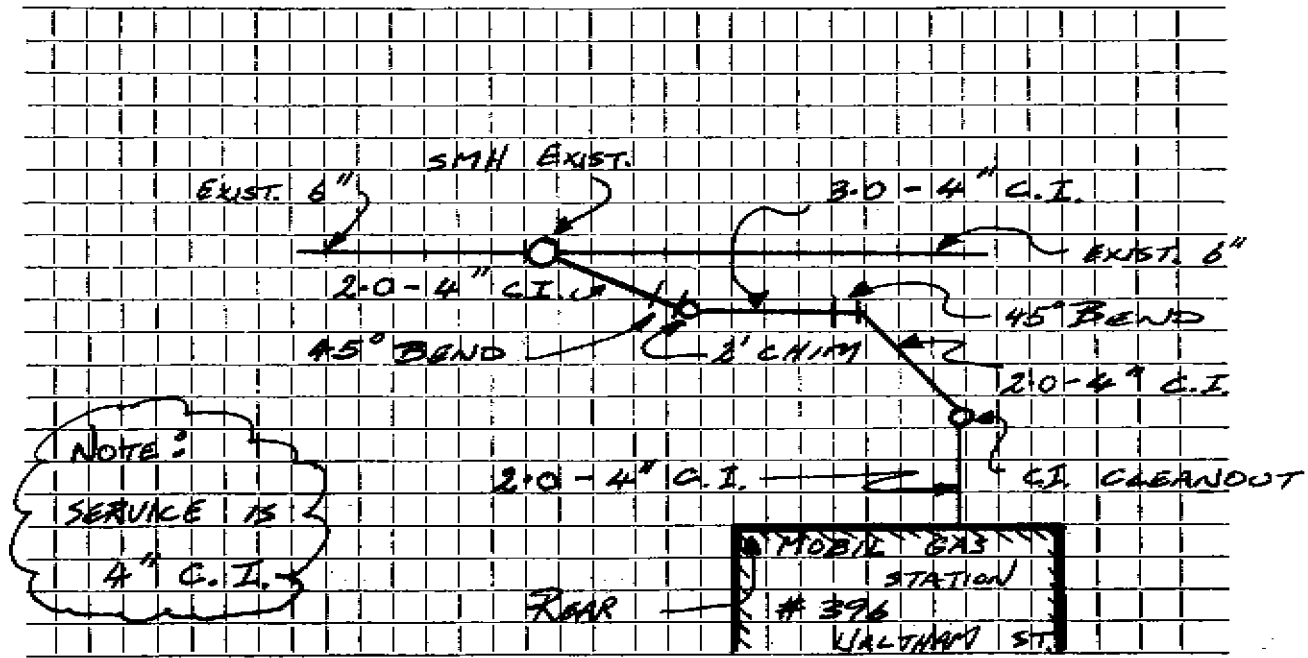

Connection made in WALTHAM Street. Work completed .....

Remarks: .....