

Name **Morris Motors** Service No. **59 (1951)**

Address **400 Waltham Street**

Lexington 400 Waltham ST. Location

Kind of Pipe _____ Size **6"** Size of Main **8"**

~~KAPLEX~~ ~~NEW SERVICE~~ **COM. 7-28-52** Location

Date	Material	Amount	Total	Date	Amount
6/30/52	Labor	80 56		6-28-52	Deposited 450 00
7/2/52	"	74 79	155 34	7-28-52	Refunded (69 49)
	10% overhead		15 53		<u>NON CHARGE</u> 280 51
	144' - 6" sewer pipe @ .342		49 24	7/2/52	Labor 74 79
	2 - 6" 1/8 bends @ 1.24		2 48		16' - 6" sewer pipe @ .342 5 47
	1 - 6x6Y		1 28		joint compound 96
	joint compound		8 64		5 2/3 hrs. Littlefield shovel 67 39 67
	18 hrs. Littlefield shovel @ 7.		126 00		1 hr. #37 compressor 1 75
	2 hrs. #37 comp. @ 1.75		3 50		2 hrs. trucking @ .75 1 50
	6 hrs. trucking @ .75		4 50		patching 16 x 4 16 00
	patching 14 x 4		14 00		<u>140 14</u>
			<u>380 51</u>		
	Labor				

TOWN OF LEXINGTON—DEPT. OF PUBLIC WORKS
SEWER DIVISION

DATE.....

NO.....


The undersigned applies for the construction of a particular sewer connecting No.....
Street and hereby agrees to comply with the Rules and Regulations governing the construction and use of Particular
Sewers, as now or at any future time established by the Board of Selectmen.

Am't of estimate \$.....

Am't Paid \$.....

..... Owner

Sketch of Service Here

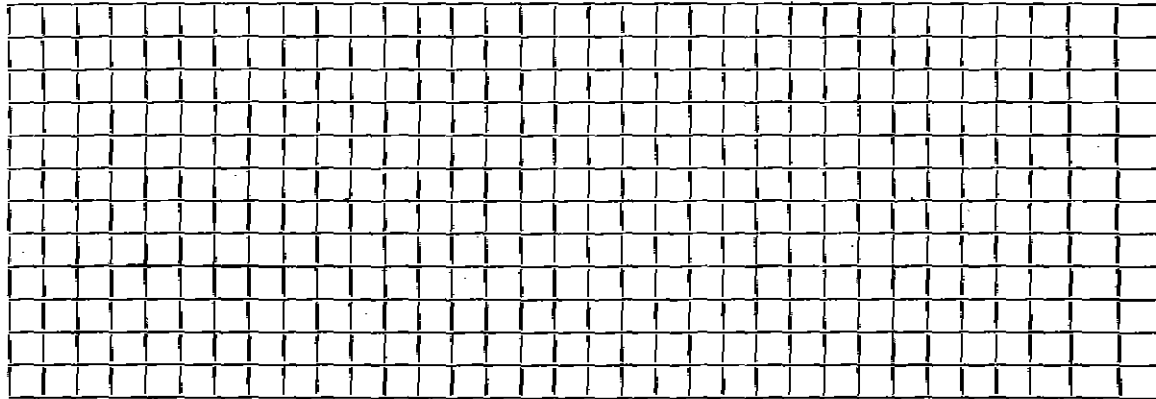

Connection made in..... Street.

Work completed..... 19..

Remarks: