

Name Homes, Land and Realty Inc.

Service No. 151

Address 405 Waltham Street

405 Waltham Street

Location

Kind of Pipe

Size 6"

Size of Main 8"

~~XXXXXXXXXXXXXXXXXXXXXXXXXXXX~~ - New Service

Location Cap. 6-21-60

Date	Material	Amount	Total	Date	Amount
11-5-60	Labor	82.05		2-22-61	200.00
	10% O.H.	8.21	90.26	4-24-61	33.96
4-6'	6" Transit pipe @.78		35.88		16.70
1	6" 90° Transit Elbow		5.40		
10 x 3	Patch		10.00		
3	hrs - Town Shovel @6.50		19.50		
1	hr - Trojan Loader @3.00		3.00		
1	hr - Trucking @3.00		3.00		
			167.04		


DATE _____

TOWN OF LEXINGTON — BOARD OF PUBLIC WORKS

SEWER DIVISION

Sketch of Service Here

405

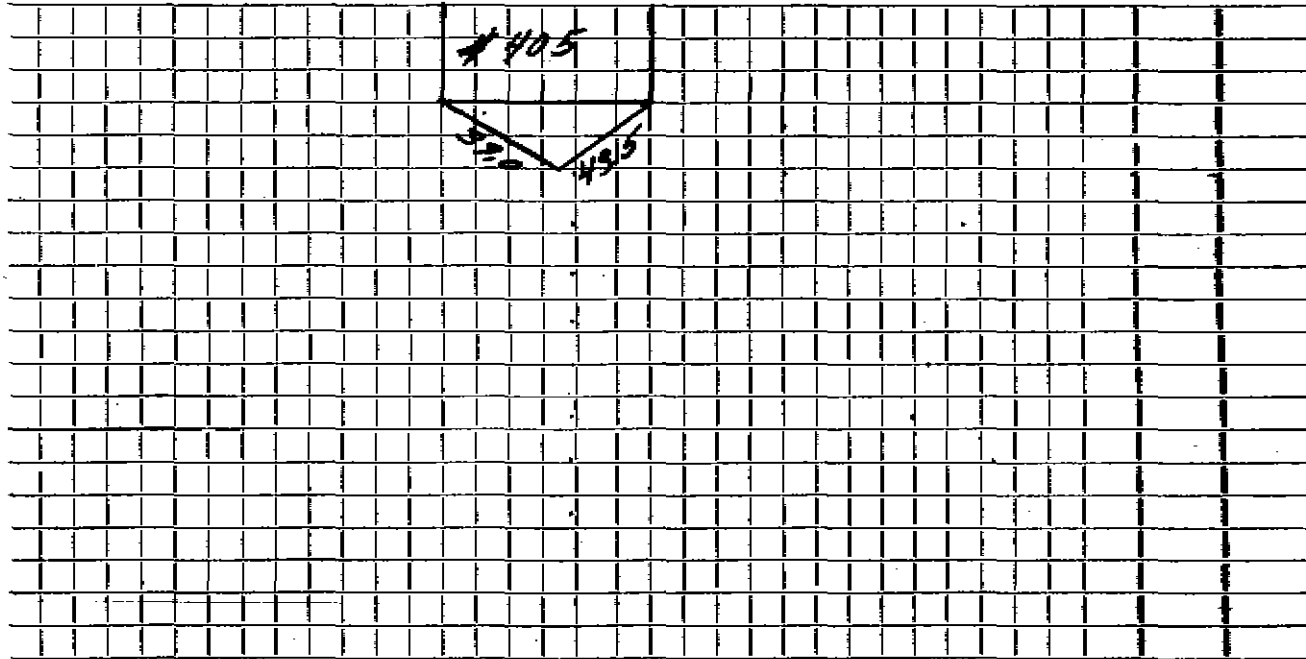

Connection made in Street. Work completed

Remarks:
.....
.....