

Name **Ralph E. Cox**

Service No. **111**

Address **410 Waltham Street**

Lexington, Mass. 410 Waltham St. Location **410 Waltham Street**

Kind of Pipe

Size **6"**

Size of Main **8"**

~~Repair~~ ~~Renewal~~ **New Service**

Com. **12-31-50**

Location

Date	Material	Amount	Total	Date	Amount
3, '50	Labor	38 1/3	38 1/3	Oct 14 '50	125 00
	10% Overhead		3 84	Dec 31 '50	27 98
	46' - 6" Sewer Pipe		12 88		97 08
	Joint Compound		2 76		
	Littlefield Shovel 4 2/3 hrs		32 67		
	Trucking 2 hrs. @ .75		1 50		
	Patching 5 x 3		5 00		
			97 08		
	Labor				

TOWN OF LEXINGTON—DEPT. OF PUBLIC WORKS
SEWER DIVISION

DATE

NO.


The undersigned applies for the construction of a particular sewer connecting No.
Street and hereby agrees to comply with the Rules and Regulations governing the construction and use of Particular
Sewers, as now or at any future time established by the Board of Selectmen.

Am't of estimate \$.....

Am't Paid \$.....

..... Owner

Sketch of Service Here

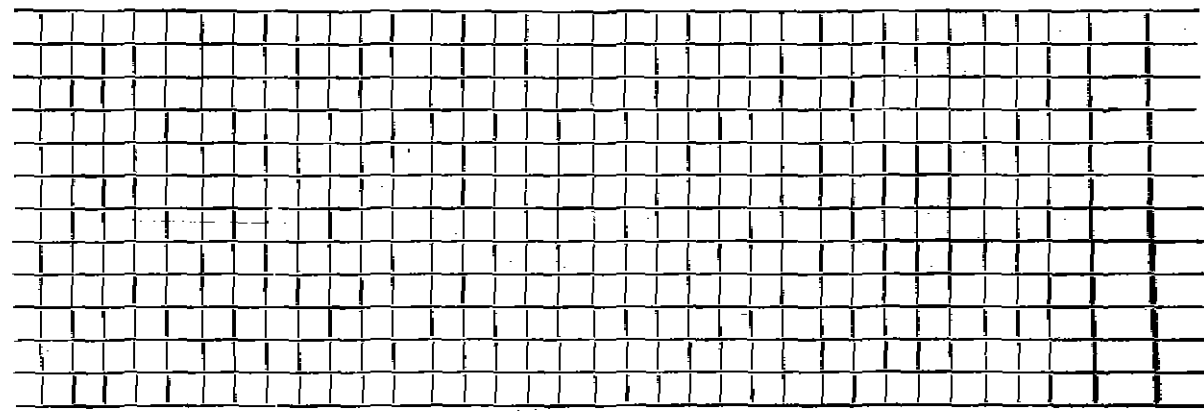

Connection made in Street.

Work completed 19..

Remarks: