

Name **John A. Spencer**

Service No. **9**

Address **439 Waltham Street**

439 Waltham Street

Location

Kind of Pipe

Size **6"**

Size of Main **8"**

~~TYPE~~ **Renewal** ~~W.O.~~ **W.O. #1706**

Location **JUN 23 1966**

Date	Material	Amount	Total	Date	Amount
-66	Labor	89.47		2-23-64	25 00
-66	Labor	25.44	114 91	8-7-66	48 21
	10% O.H.	11 49	126 40		123 21
37'	6" Transite pipe @ .82		30 34		
1/2	Bag Cement @ 150		75		
1	Doz Brick @ 4.20 per 100		1 02		
1/4	Ton hot top @ 5.50		1 38		
1	Yard Loam		3 00		
1	Lb Seed		1 05		
1/2	Bag Fertilizer @ 4.00		2 00		
4	Hrs. Truck @ 3.00		12 00		
2	Hrs. Tractor @ 6.50		13 00		
1	Hr. Roller		3 00		
1	Hr. Trailer		2 00		
1	Hr. Compressor		5 00	Pro-Rated	123 21
			200 94		25

Deposit Paid

Bill sent 48.21


200.94 x 15.333 = 25

DATE _____

TOWN OF LEXINGTON — BOARD OF PUBLIC WORKS

SEWER DIVISION

Sketch of Service Here

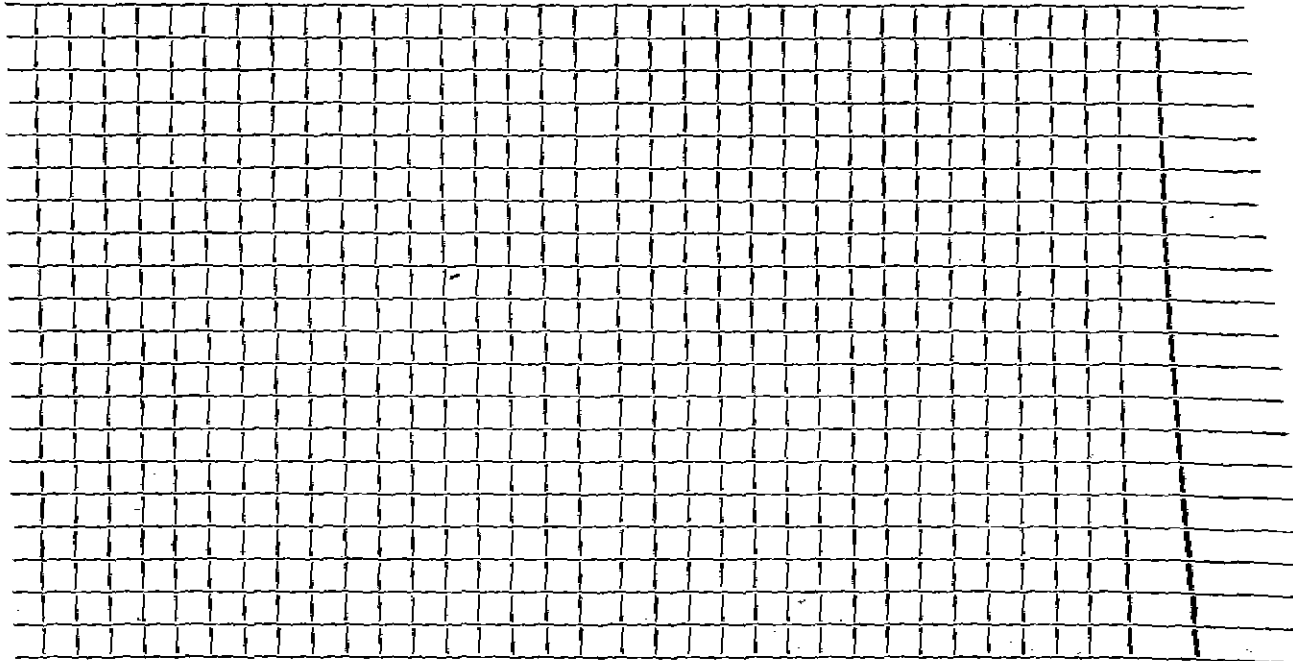

Connection made in Street. Work completed

Remarks: Original Service 10-9-50 (42'-6" Sewer Pipe)