

Name Richard Pulkkinen

Service No. 127

Address 443 Waltham Street

443 Waltham Street

Location

Kind of Pipe

Size 6"

Size of Main 8"

Report ~~RENEW~~ New ServiceLocation *Comm 11-24-58*

Date	Material	Amount	Total	Date	Amount
7/23/58	Labor	26 78		7-16-58	200 00
	10% overhead	2 68		11-24-58	88 55
		29 46	29 46		111 45
	55' 6" Transite Pipe @ .70		38 50		
	1 22 $\frac{1}{2}$ " 6" Transite Bend		6 21		
	1 11 $\frac{1}{2}$ " Transite Elbow		2 24		
	1 6" 90° Transite Elbow		5 29		
	2 hr. Town Shovel @ 6.50		13 00		
	1 hr. Trucking @ .75		75		
	1 hr. Trucking @ 3.00		3 00		
	1 hr. Rogers Trailer @ 3.00		3 00		
	10 x 3 Patch		10 00		
	Labor		111 45		

TOWN OF LEXINGTON—DEPT. OF PUBLIC WORKS
SEWER DIVISION

DATE.....

NO.....


The undersigned applies for the construction of a particular sewer connecting No.....
Street and hereby agrees to comply with the Rules and Regulations governing the construction and use of Particular
Sewers, as now or at any future time established by the Board of Selectmen.

Am't of estimate \$.....

Am't Paid \$.....

..... Owner

Sketch of Service Here

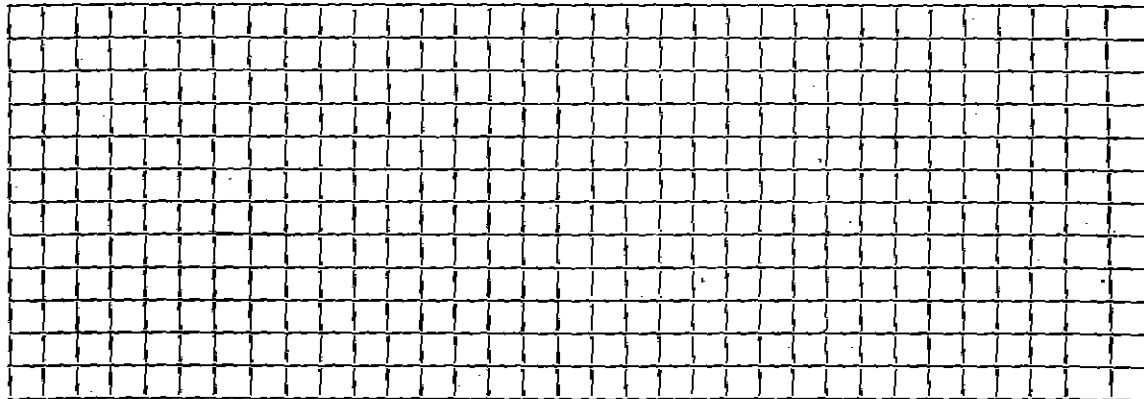

Connection made in..... Street. Work completed..... 19..

Remarks: