

Service No. 101

Address 19 Williams Street

449 William Street

Kind of Pipe

Size 6"

Size of Main 8"

Work - Renewal - ~~Williams Street~~ V.O. #92

Location

DEC 26 1978


Date	Material	Amount	Total	Date	Amount
11-21-78	Labor	116.10		11-20-78	Repair
	10% O.H.	11.61	127.71		Refund
20'	6" Transite pipe @1.50		30.00		
1	4" Post		2.05		OUTSIDE V.O. #95
2	yds. Loan @5.44		10.88	11-20-78	Labor
1	lbs. Grass Seed @.74		2.22	2	6" x 10' Transite pipe
1 1/2	hrs. Trucking @3.00		4.50	1	6" x 8" Saddle
2	hrs. Backhoe @6.50		13.00	1	6" x 30' Transite band
			191.36	1	6" x 5' Nipple
				2	ton Cold Patch
					Patch Sidewalk 8 x 5
					Patch Street 8 x 12
				7	hrs. Trucking
				1	hr. Roller
				3 1/2	hrs. Town Shovel
				1	hr. Compressor
				1	hr. Loader

DATE _____

TOWN OF LEXINGTON — BOARD OF PUBLIC WORKS

SEWER DIVISION

Sketch of Service Here

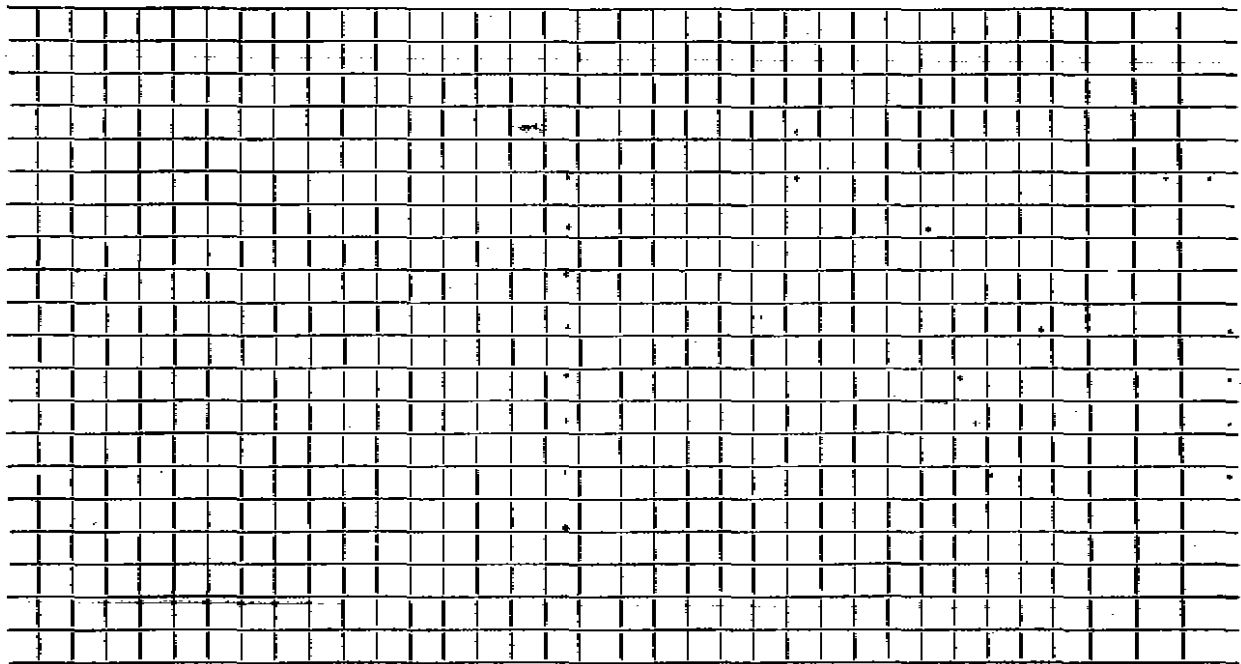

Connection made in Street. Work completed

Remarks: *Original Service 10-31-50 (96'-6" Sewer Pipe)*