

Name Charlotte Maxner

Service No. 133 (1956)

Address 462 Waltham Street

462 WALTHAM STREET

Location

Comm. 3/18/57

Kind of Pipe

Size 6"

Size of Main 8"

~~SPUR SERVICE~~ - New Service

Location

Date	Material	Amount	Total	Date	Amount
10-4-56	Labor	120.80		9-13-56	Deposit \$ 200.00
	10% O.H.	12.08	132.88	3-10-58	Paid 30.78
	70' 6" Sewer pipe @.435		30.45		230.78
	Joint Compound		4.20		
	3 Hrs. Trucking @.75		2.25		
	6 Hrs. Town Shovel @ 6.50		39.00		
	22 x 3 Patch		22.00		
			230.78		
	Labor				
					Bill sent 3/19/57

TOWN OF LEXINGTON—DEPT. OF PUBLIC WORKS

SEWER DIVISION

DATE

NO.


The undersigned applies for the construction of a particular sewer connecting No. Street and hereby agrees to comply with the Rules and Regulations governing the construction and use of Particular Sewers, as now or at any future time established by the Board of Selectmen.

Am't of estimate \$.....

Am't Paid \$.....

..... Owner

Sketch of Service Here

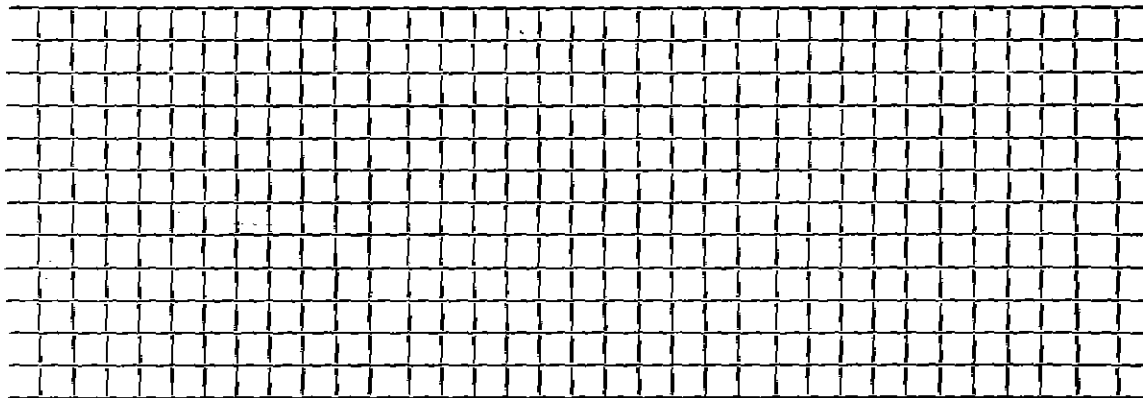

Connection made in Street.

Work completed 19..

Remarks: