

Name **Annie Baker**

Service No. **54 (1953)**

Address **475 Waltham Street**

**475 WALTHAM STREET**

Location

Kind of Pipe

Size **6"**

Size of Main **8"**

~~Repair~~ **New Service**

CON. **3-22-54**

Location

Date	Material	Amount	Total	Date	Amount
2/54	Labor	52 30		3-17-53	150 -
	10% overhead	5 23	57 53	3-22-54	(14 77)
	48' - 6" sewer pipe @.3087		14 82		135 23
	joint compound		2 88		
	7 hrs. Littlefield shovel @ 7.50		52 50		
	2 hrs. trucking		1 50		
	patching 6 x 3		6 00		
			135 23		
	<b>Labor</b>				

TOWN OF LEXINGTON—DEPT. OF PUBLIC WORKS

**SEWER DIVISION**

DATE .....

NO. ....


The undersigned applies for the construction of a particular sewer connecting No. ....  
Street and hereby agrees to comply with the Rules and Regulations governing the construction and use of Particular  
Sewers, as now or at any future time established by the Board of Selectmen.

Am't of estimate \$.....

Am't Paid \$.....

..... Owner

**Sketch of Service Here**

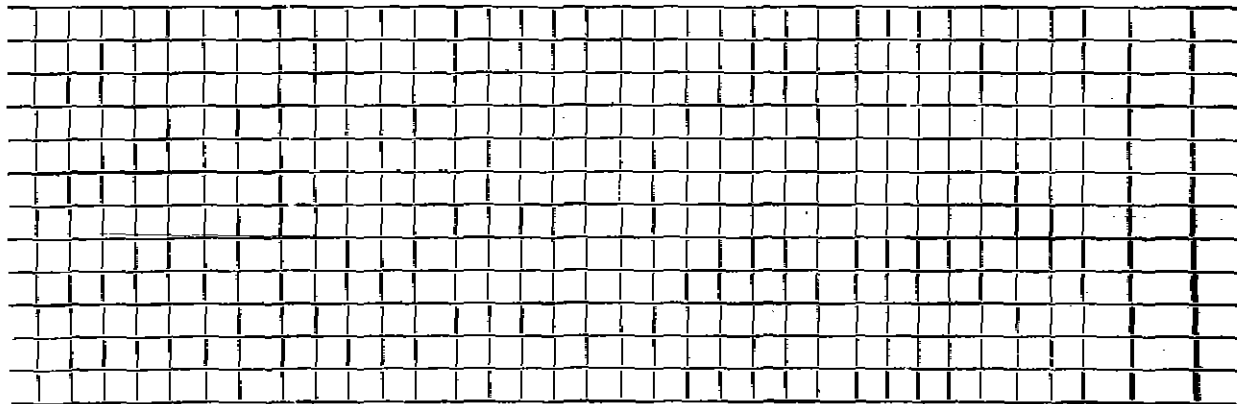

Connection made in ..... Street.

Work completed ..... 19..

Remarks: