

Service No. 33

33

Address * 79 Waltham St. Lot 26

79 W 21 THAM STREET Location

Kind of Pipe Size 6" Size of Main 8"

Inspector Valeri # 3998 Location OCT 21 1965


Qty	Material	Amount	Total	Date	Amount
56	6" Transit pipe @ 5.00		147.50	9-21-65	147.50
5	6" P.V.C.				
	4" IRON				
1	ROUNE				
1	TRANSITE TO PVC ADAPTOR				

DATE _____

TOWN OF LEXINGTON — BOARD OF PUBLIC WORKS

SEWER DIVISION

Sketch of Service Here **479**

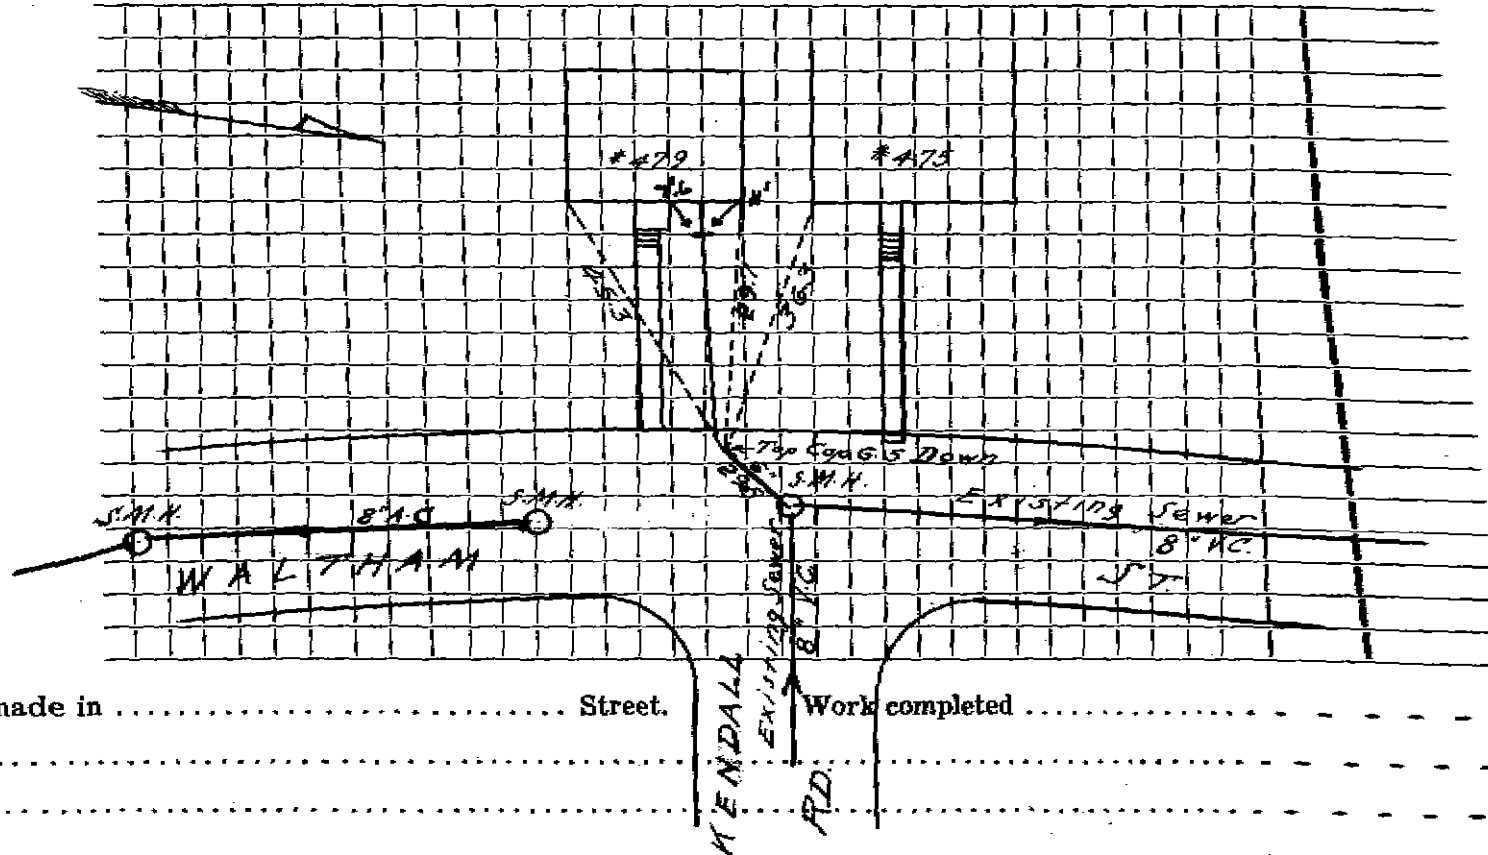

Connection made in Street. Work completed

Remarks:

.....

.....

.....