

Name **Alvin J. Woodward**

Service No. **38**

Address # **485-487 Waltham St Lot 18**

485 + 487 Waltham Street

Location

Kind of Pipe

Size **6"**

Size of Main **8"**

~~Repair~~ **New Service** Faulkner #4989


Location

Date		Material	Amount	Total	Date		Amount
'66	24 1/2	6" Transite pipe @ 5.00		122.50	8/9/67	Paid	122.50
'87	97'	6" PVC					
	5'	6" PVC					
	27'	4" Cast					
	6'	4" Cast					
	4"	4" 45° Bends					
	1	6" x 6" AC to PVC Fernco					
	1	4 x 6 Fernco					
	1	5' M.H.					
	1	FRAME & Cover					

DATE _____

TOWN OF LEXINGTON — BOARD OF PUBLIC WORKS

SEWER DIVISION

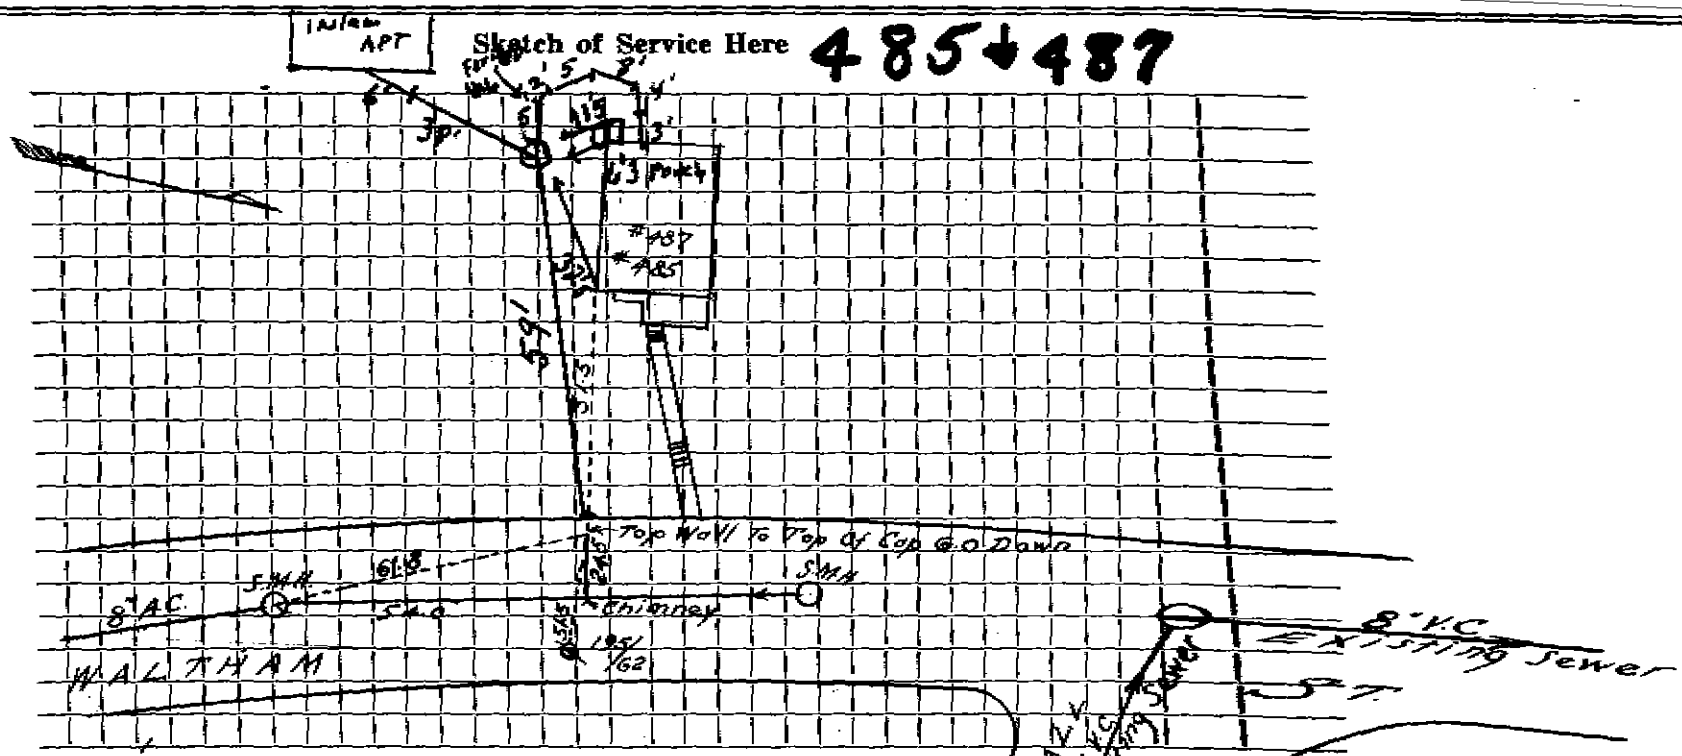

Connection made in Street. Work completed

Remarks:
.....
.....

KENDALL
LEXINGTON
AR. DI.