

Name

Contractor: Vanavia

Service No.

Address

487 Waltham St

Location

Kind of Pipe

SDR 35 PVC

Size

6"

Size of Main

Repair

~~Renewal~~

New Service

Location

Date

Material

Amount

Total

Date

Amount

7/30/19

6" cleanout

6" PVC

45° bend

6" PVC


45° bend

fern Co

DATE 7/30/19

TOWN OF LEXINGTON — BOARD OF PUBLIC WORKS
SEWER DIVISION

Sketch of Service Here

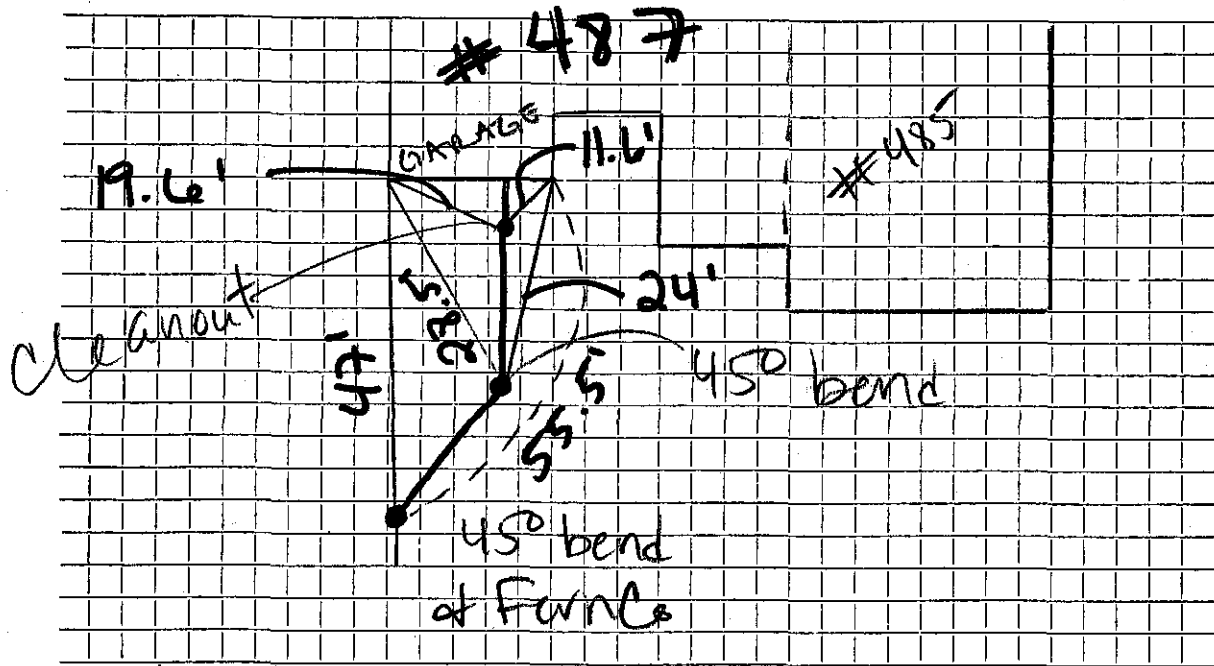

Connection made in Waltham Street. Work completed

Remarks:
.....
.....